

DUBLIN GRANVILLE ROAD

15' PLANTING

STRIP



No Curb

BLACKTOP

25' SERVICE DRIVE R/W

conc. apron

Back of Curb

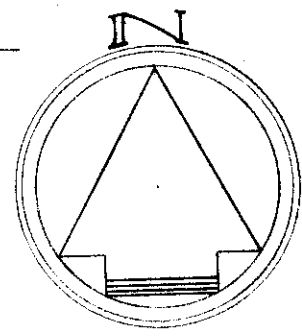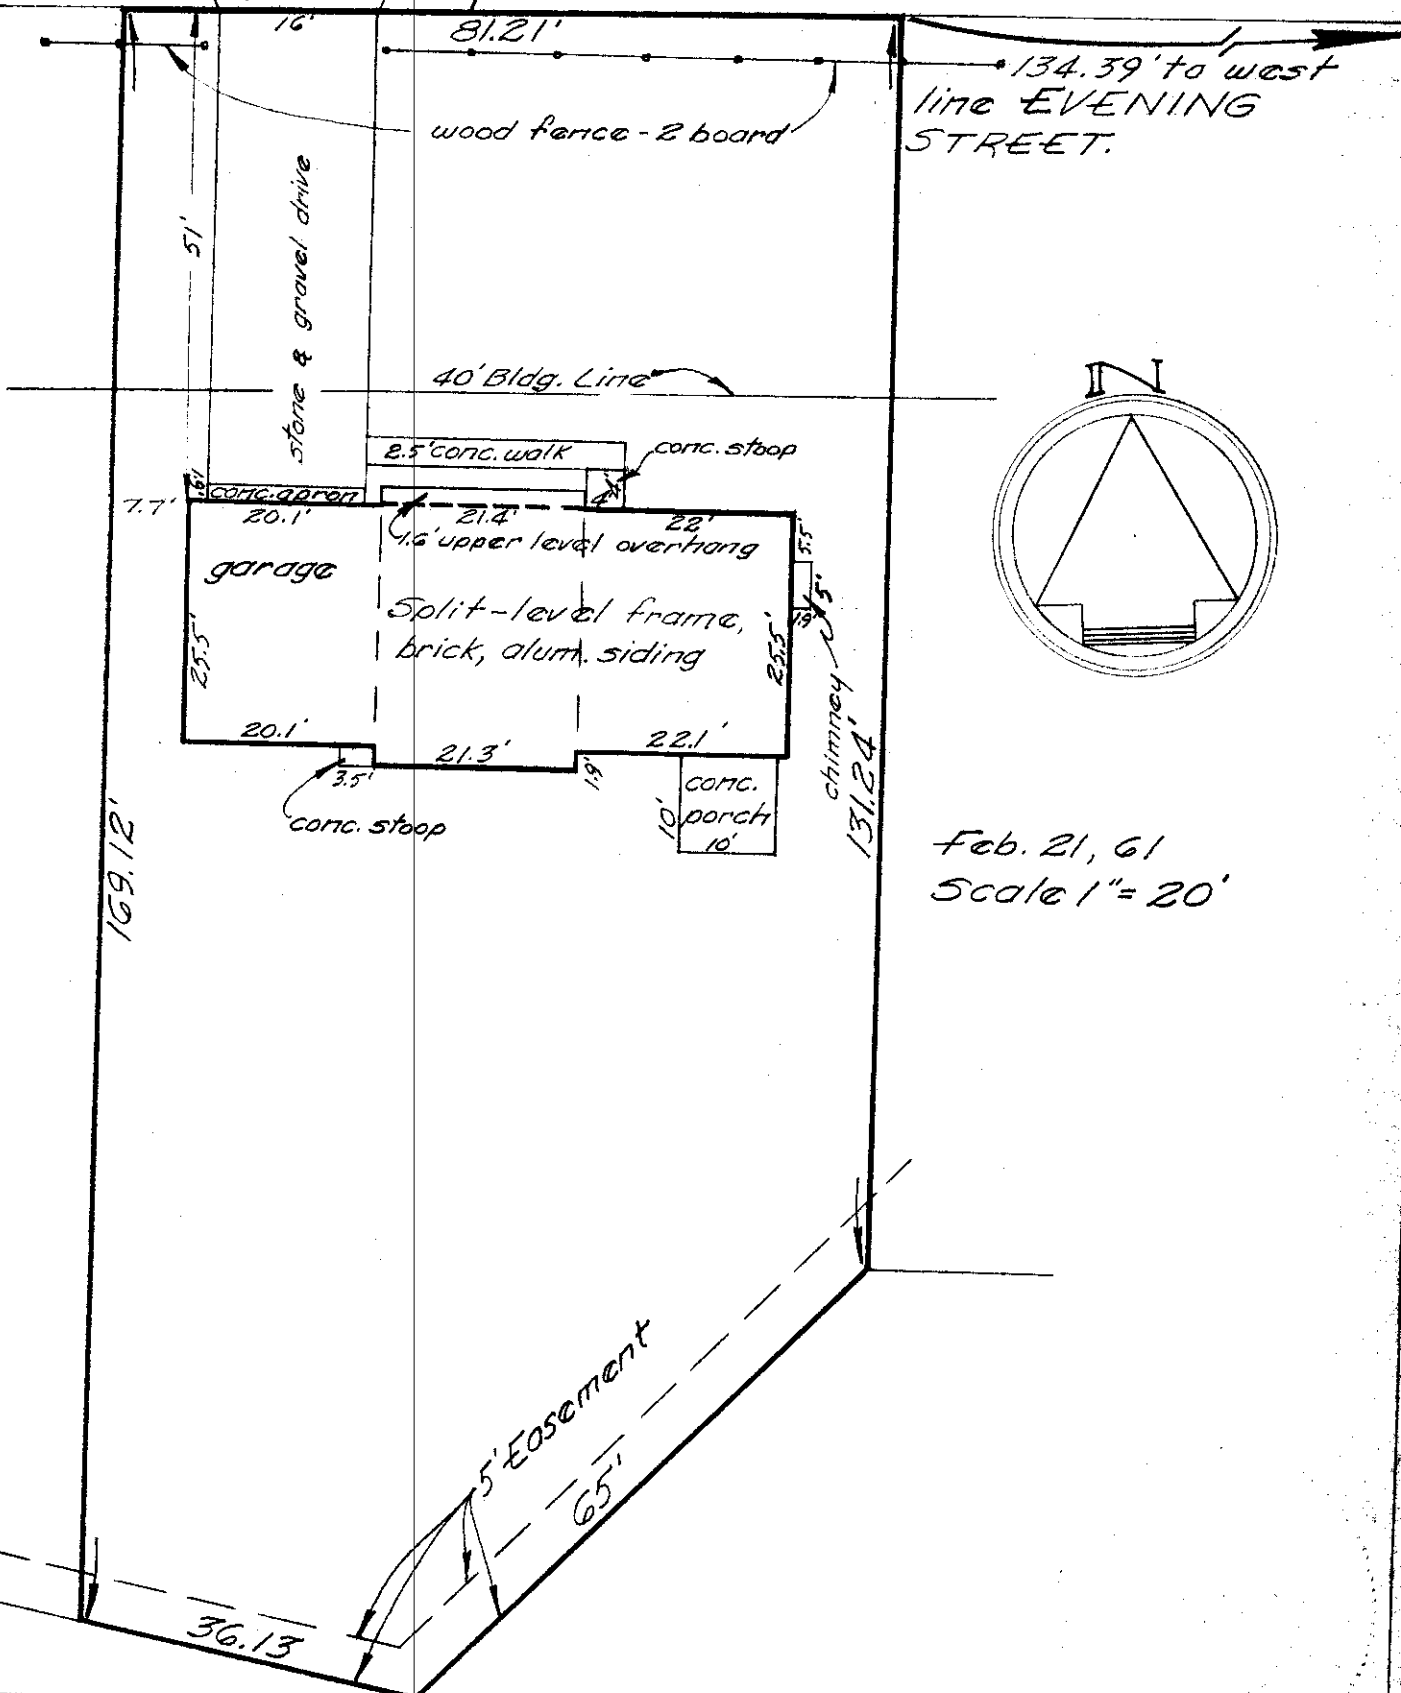

Feb. 21, 61
Scale 1" = 20'

— 155 DUBLIN GRANVILLE ROAD —
 City of WORTHINGTON, FRANKLIN COUNTY, OHIO.
 Albright Mortgage Company.
 by: RICHARD P. PETICOLAS.
 — BLUE PRINT SURVEY —
 I hereby certify that I have prepared the above plat from survey
 and inspection of herein described premises, and existing
 conditions are as shown above.
 being Lot No. 13, of KILBOURNE VILLAGE, of record in Plat
 Book 28, pgs. 62 & 63, Recorder's Office, Franklin County, Ohio.
 Harry L. Greene, Reg. Surveyor - No. 4058.

21-02-61