

MCCOY

16"± Macadam Improvement  
No Curbs

ROAD

ROAD

31' Improvement

5.0' Right-of-Way

WINDERMERE

RESERVE "C"  
For Street Purposes

Back of curb


4' conc. walk

156.13'

20' Building Line

40' Building Line

Blocktop Drive

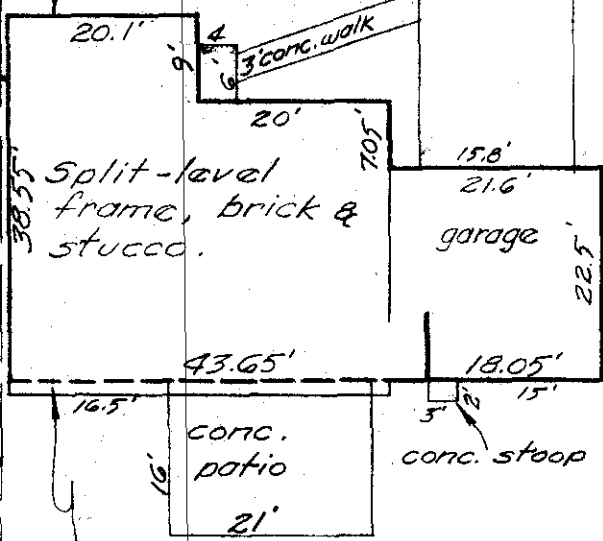

94.58'

419'

23.5'

30'

25' Right-of-Way

21'

20.1'

20'

38.55'

16.5'

16'

21'

70.5'

43.65'

1.4' upper-level overhang

10' Easement

94.58'


156.01'

11.8'

22.5'

15'

20'

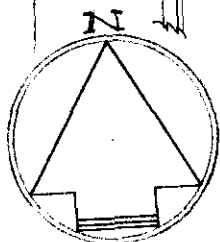

Jan. 12-1960  
Scale 1" = 20'

Revised Mar. 22, 1961  
CASE No. 41509

22-03-61

2341 MCCOY ROAD

City of Upper Arlington, Franklin County, Ohio.  
Lawyers Title Insurance Corp. & Pacific Mutual Life Insurance Company.  
Re: Clayton K. Jones, Robert T. Davis.

Blue Print Survey

I hereby certify that I have prepared the above plat from survey and inspection of herein described premises and existing conditions are as shown above.

Being Lot No. 1, Block 3, of MIDDLESEX PLACE No. 2, of record in Plat Book 30, pages 30-31, Recorder's Office, Franklin County, Ohio.

Harry L. Greene

Harry L. Greene, Reg. Surveyor - No. 4058.