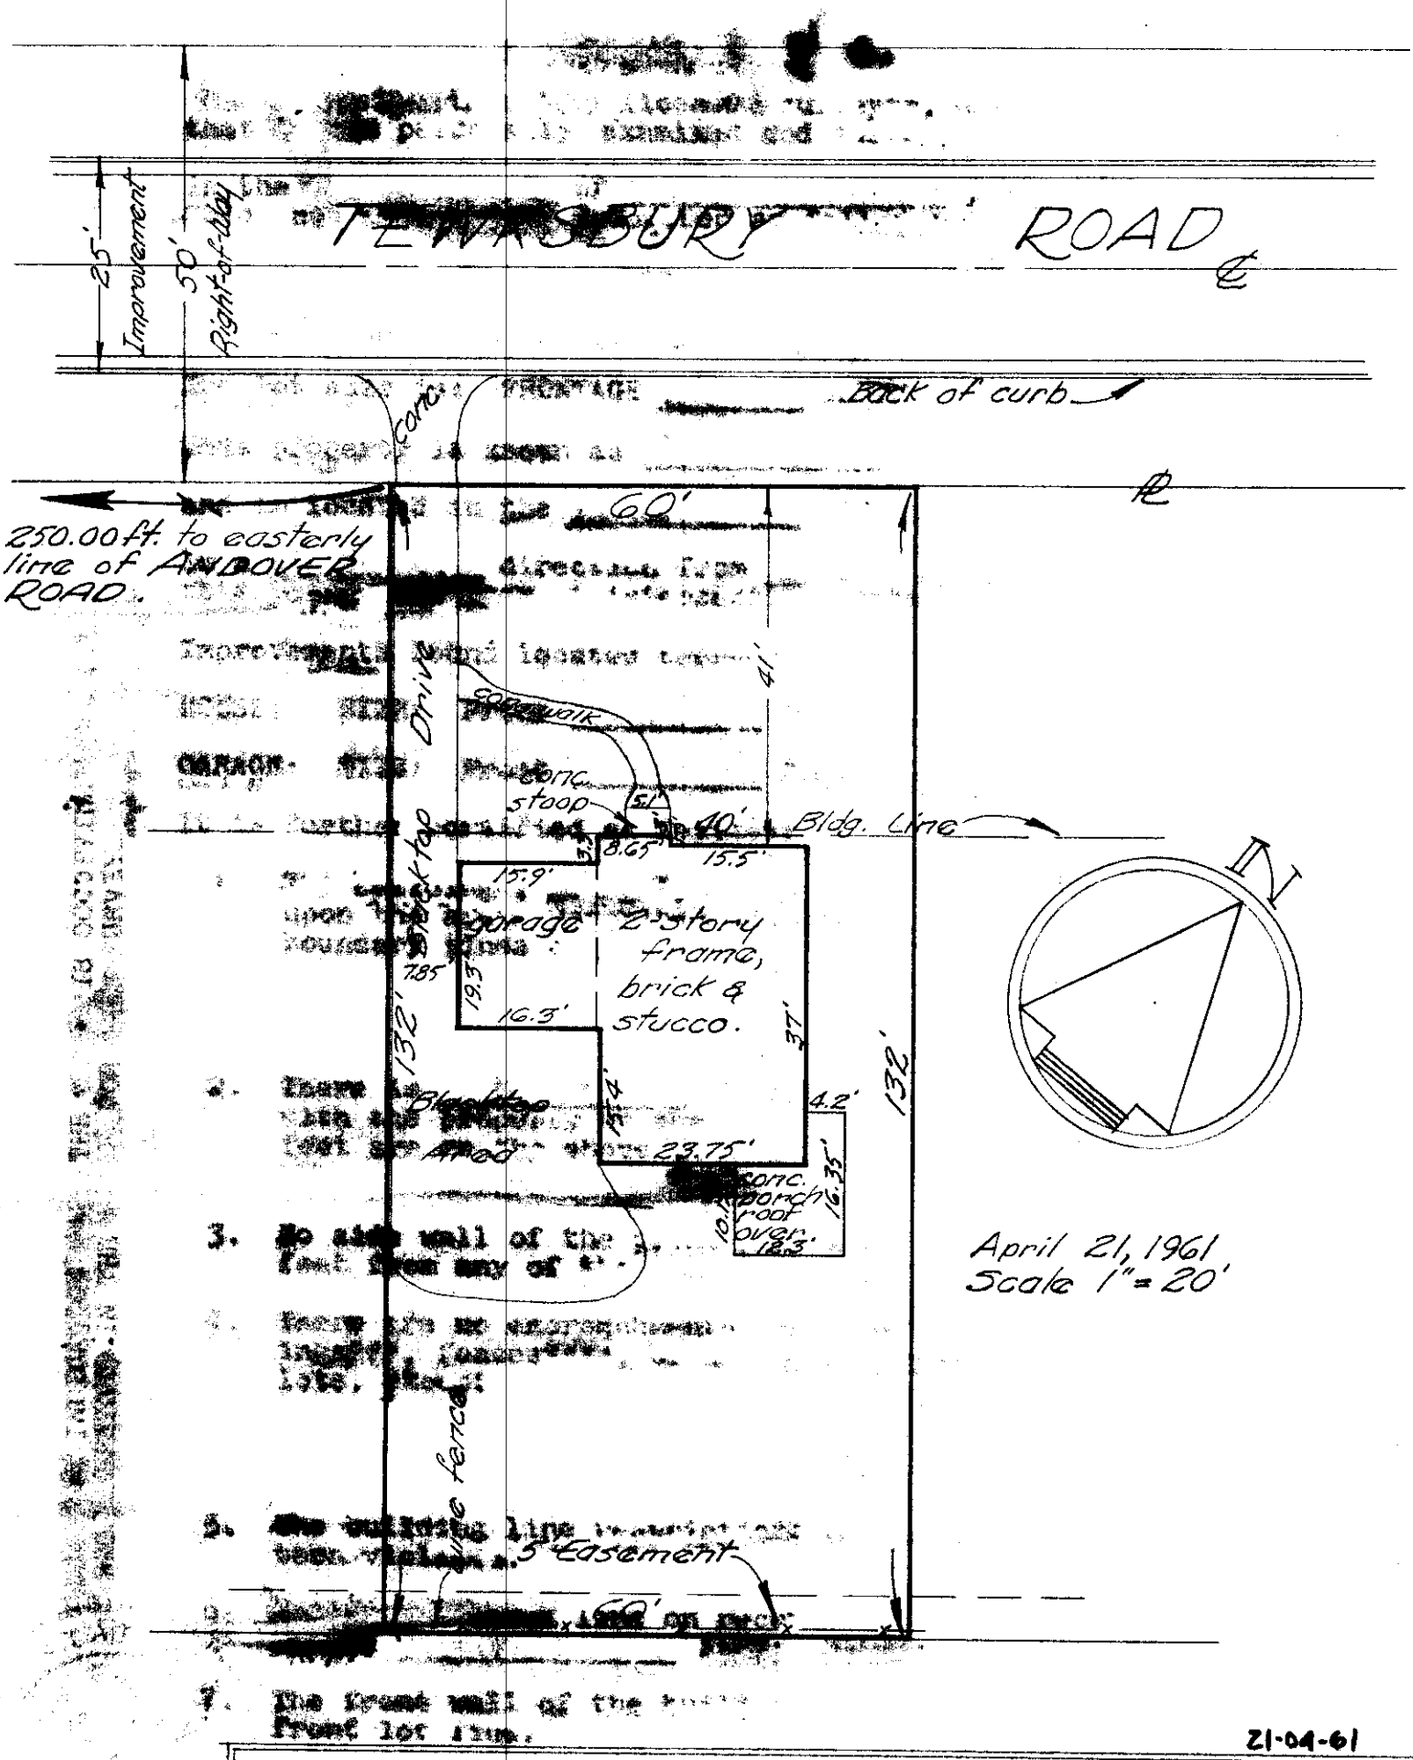

1863 TEWKSBURY ROAD
Upper Arlington, Franklin County, Ohio.

~ BLUE PRINT SURVEY ~
for
Charles H. & Marianne M. Hamilton.

I hereby certify that I have prepared the above plat from a survey and inspection of herein described premises and existing conditions of the above improvement, on Lot No. 5, Block 145, of THE UPPER ARLINGTON CO.'S PLAT OF BLOCKS 60 & 126 TO 150, VILLAGE OF UPPER ARLINGTON (EXCEPTING BLOCKS 140 & 143), Plat Book 18, Page 34-35, Recorders Office, Franklin County, Ohio.

Harry L. Greene
Harry L. Greene, Reg. Surveyor, No. 4058.