


0.68926 Acres

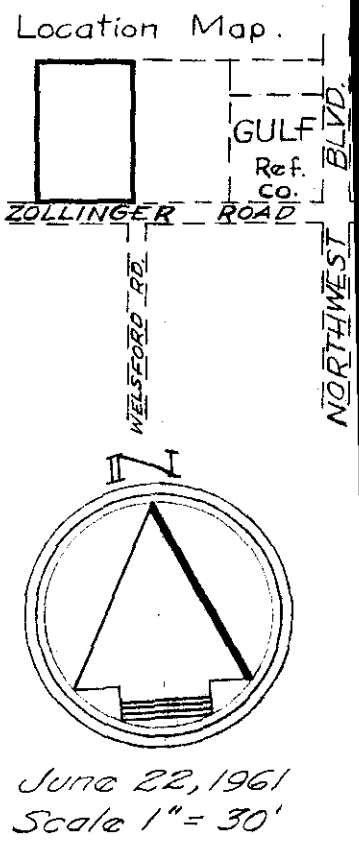

139.54 ft. from S.W. Cor. Gulf Refining Tract

ZOLLINGER ROAD

WELSFORD ROAD

SCHOEDINGER & Co. Premises.
City of Upper Arlington, Franklin County, Ohio.
Danohio Mortgages Inc. &
Louisville Title Insurance Co.

22-06-61 A

Blue Print Survey

I hereby certify that I have prepared the above plat from survey and inspection of herein shown premises, and existing conditions are as shown above.

Harry L. Greene

Harry L. Greene, Reg. Surveyor - No. 4058.