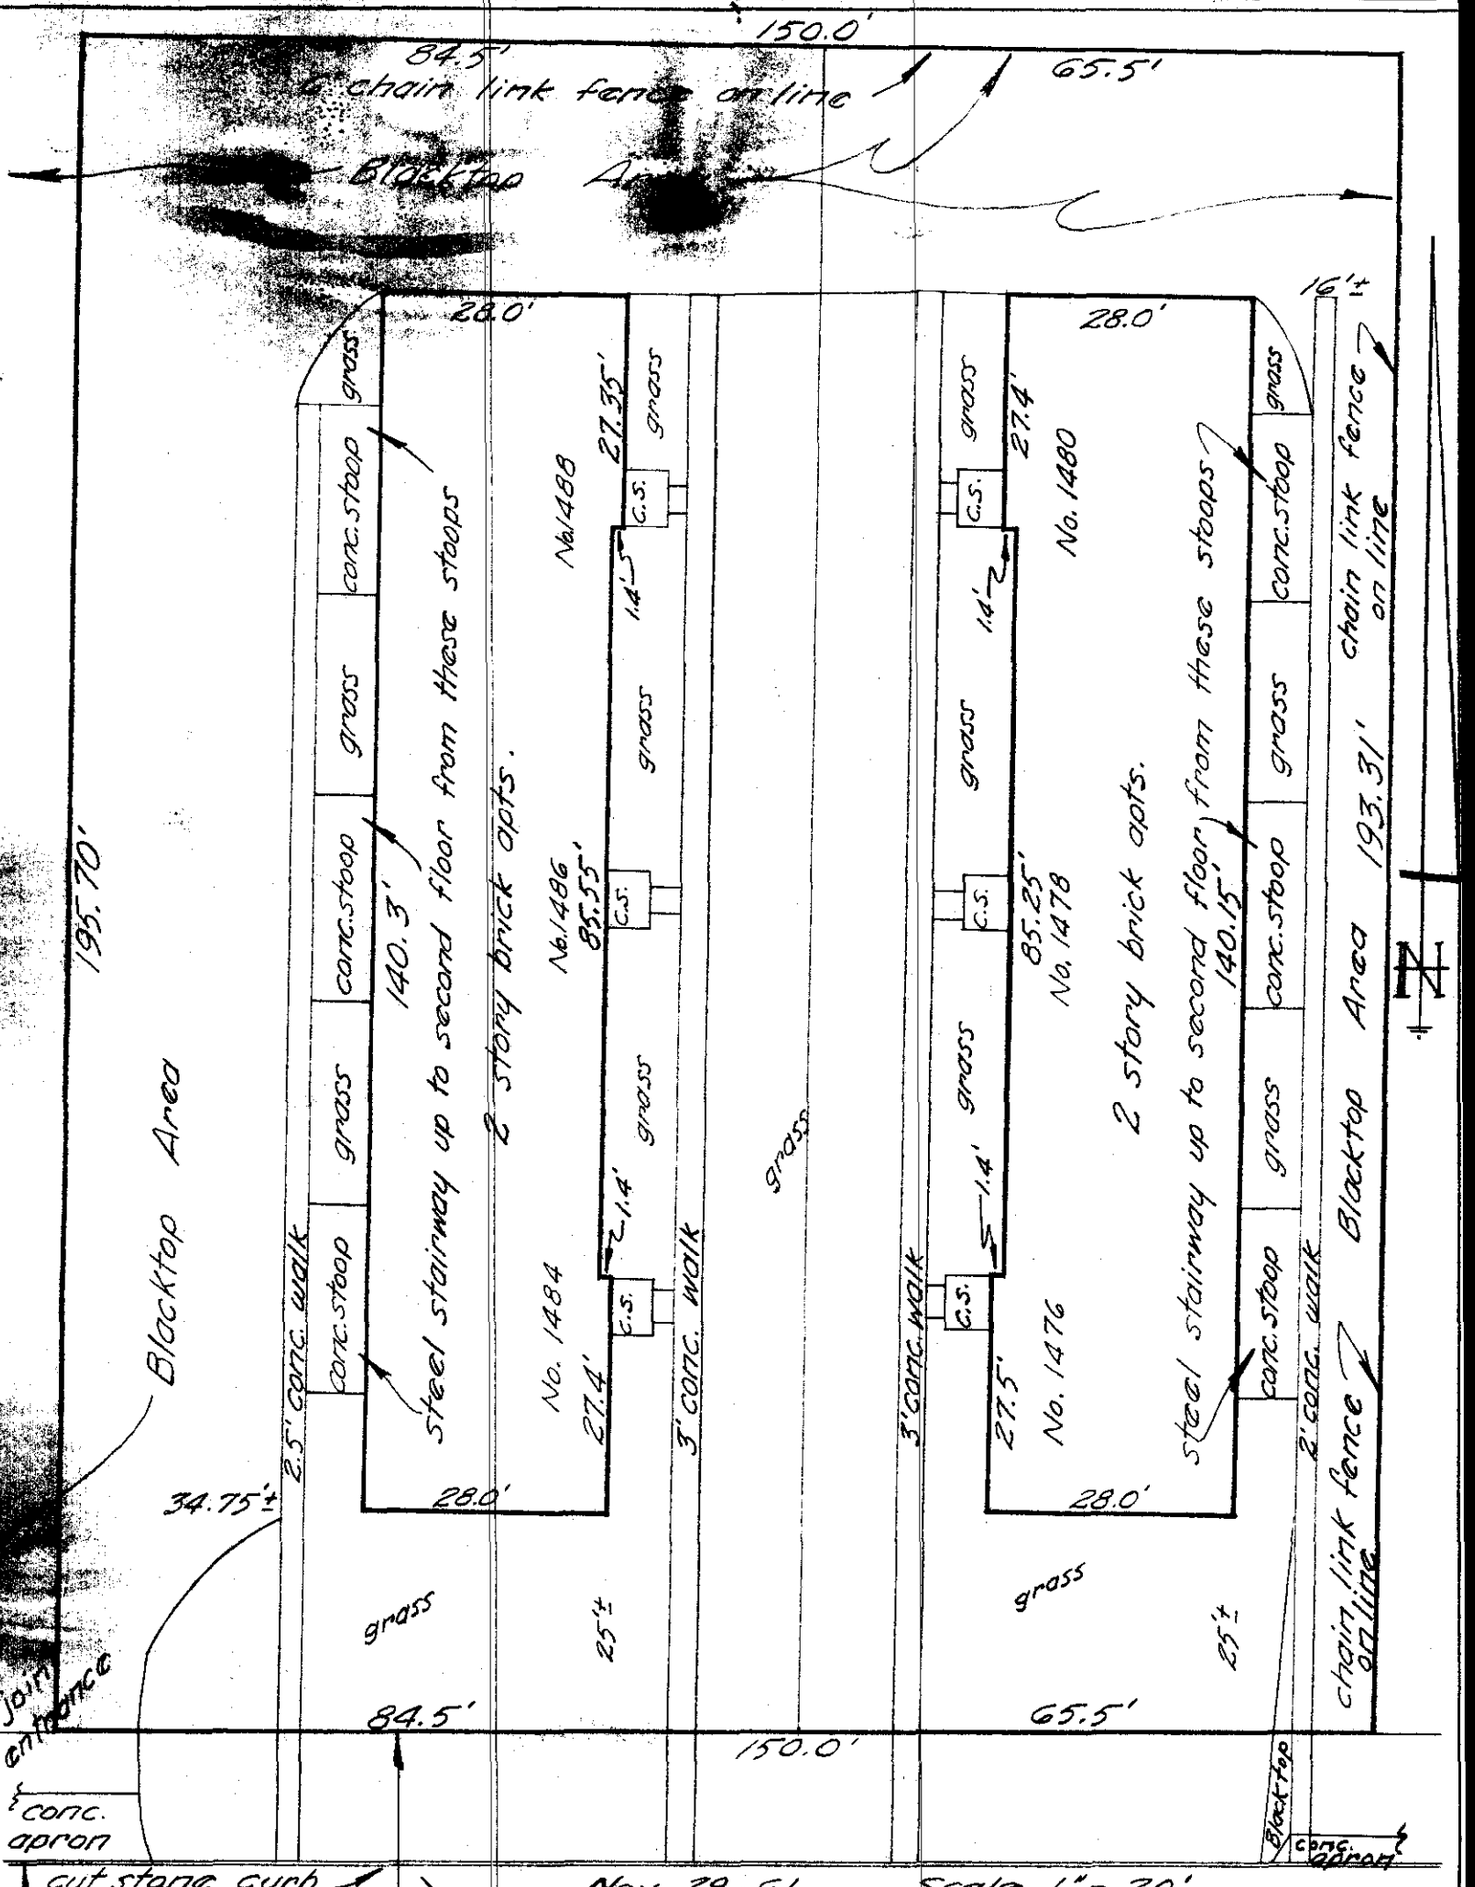

Nov. 29-61 Scale 1" = 20'

Plat showing apartments known as 1476-78-80 and 1484-86-88; King Ave., City of Columbus, Franklin County, Ohio, and being located on part of Lot No. 28 of the R. E. Neil sole surviving Trustee of John G. Neil and Family subdivision, as the same is shown of record in Plat Book 4, page 130, Recorder's Office, Franklin County, Ohio.

I hereby certify that I have prepared the above plat from survey and inspection of herein described premises and existing conditions are as shown above.

Harry L. Greene

Harry L. Greene, Reg. Surveyor No. 4058.

29-11-61