
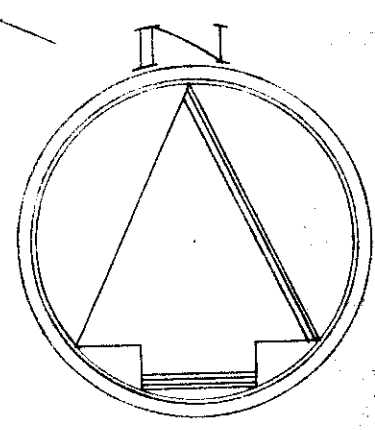


STINSON
50' Right-of-Way

DRIVE
27' Improvement

EVANSDALE
ROAD

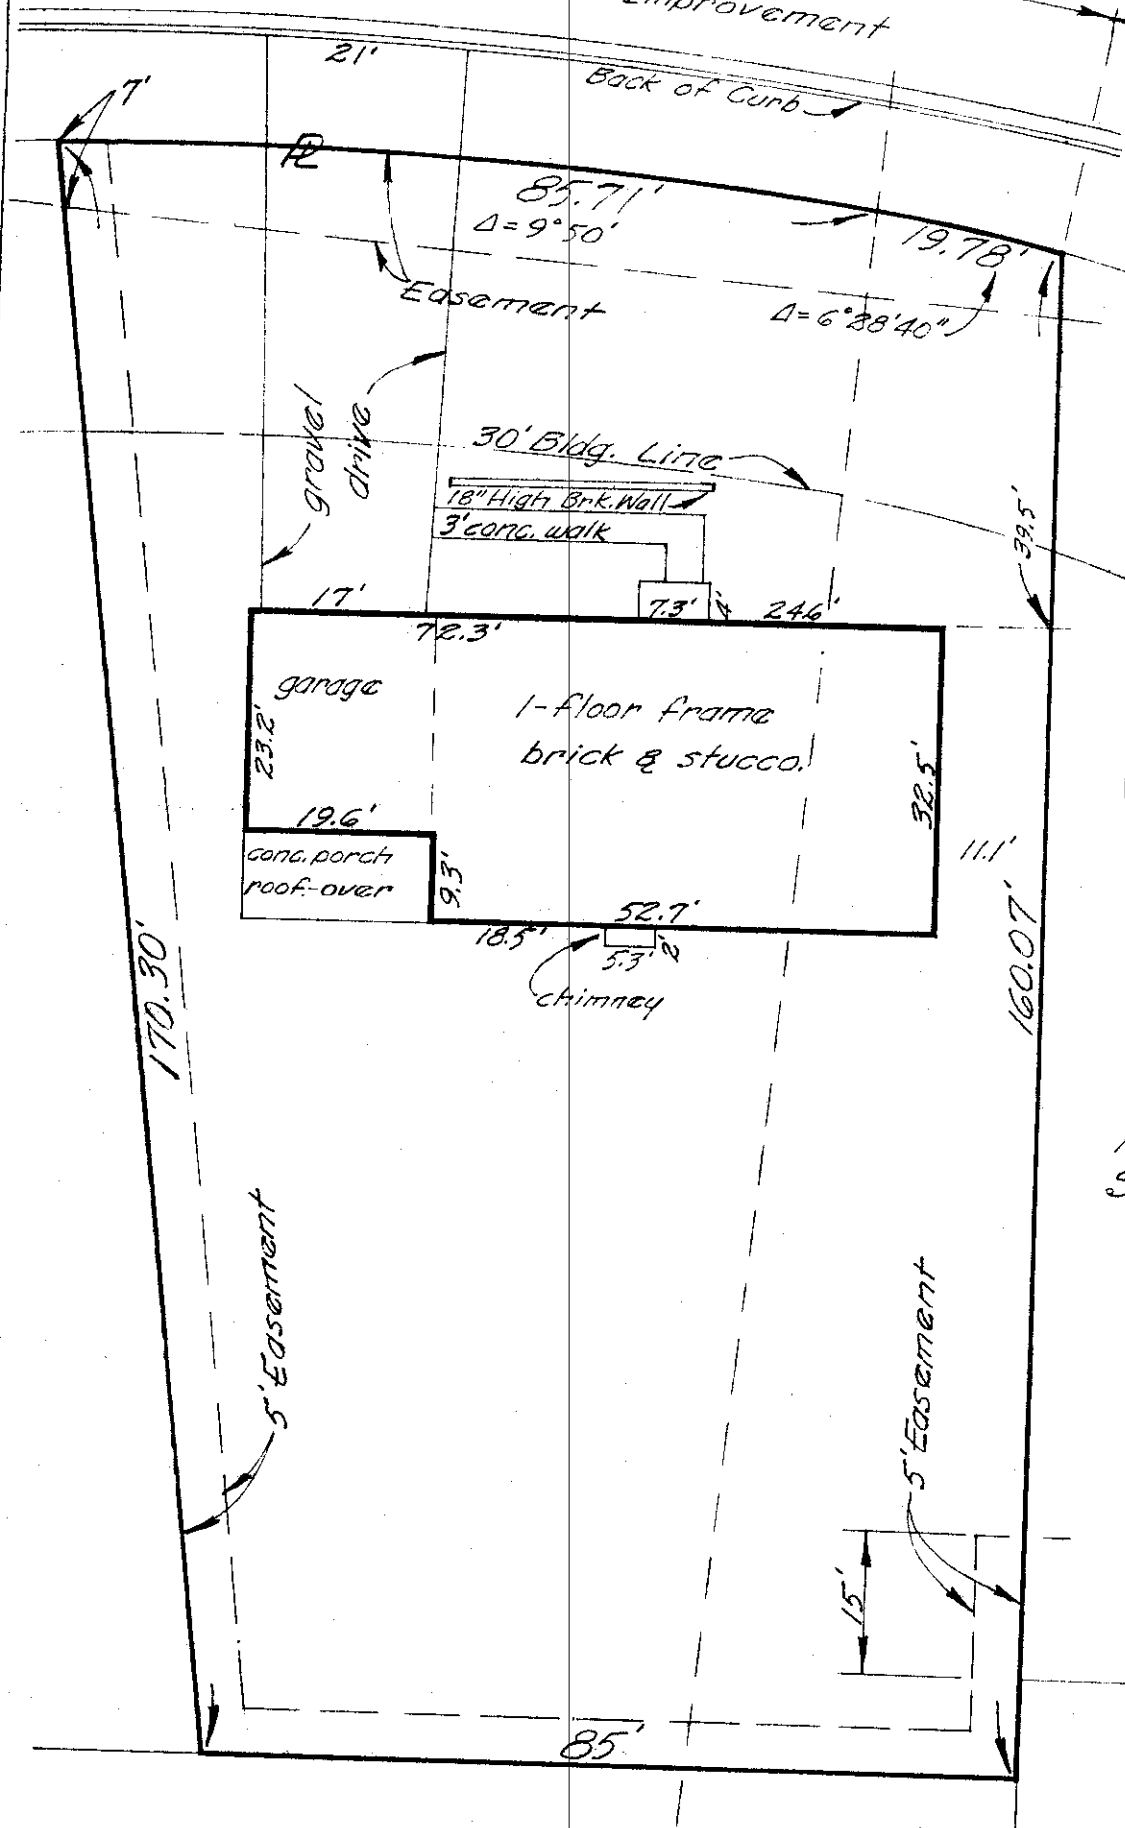

May 21-62
Scale 1" = 20'

609 STINSON DRIVE
 City of Columbus, Franklin County, Ohio.
 THE TITLE CORP. & NORTHWESTERN MUTUAL LIFE
 INS. CO.
 by: Allan B. Caris.

— BLUE PRINT SURVEY —

I hereby certify that I have prepared the above plat
 from survey and inspection of herein described premises,
 and existing conditions are as shown above.
 being Lot No. 64 of THE KNOLLS SECTION No 2,
 record in Plat Book 33, pg. 122, Recorder's Office,
 Franklin County, Ohio.

Harry L. Greene, Reg. Surveyor - No. 4058.
 Harry L. Greene
 21-05-62