


KENDALE ROAD

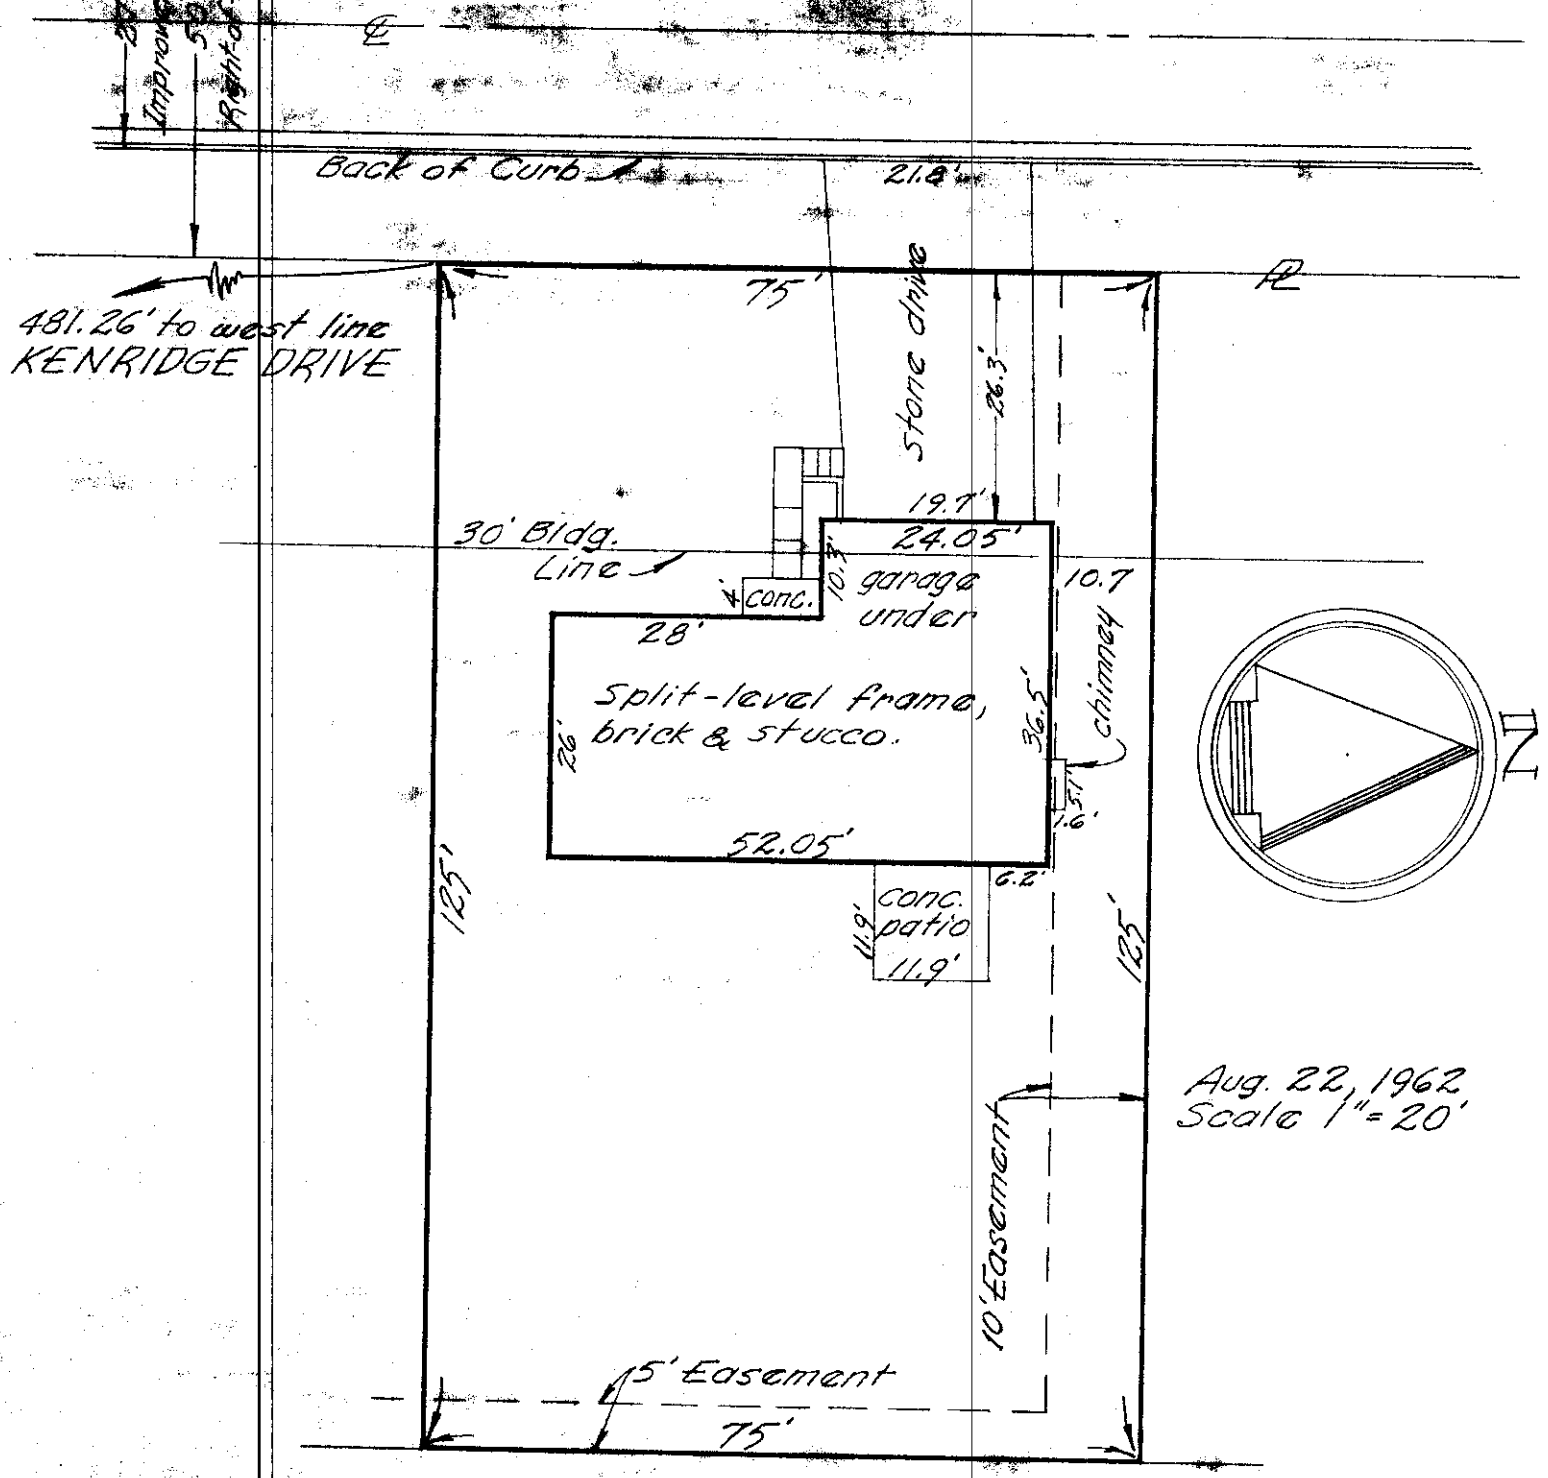

4134 KENDALE ROAD

City of Columbus, Franklin County, Ohio.
Galbreath Mortgage Company
Re: Frank Guarasci.

BLUE PRINT SURVEY

I hereby certify that I have prepared the above plat from survey and inspection of herein described premises, and existing conditions are as shown above.

Being Lot No. 180 of KENDALE SECTION No 2, of record in Plat Book 34, pg. 1, Recorder's Office, Franklin County, Ohio.

Harry L. Greene

Harry L. Greene, Reg. Surveyor - No. 4058

22-08-62