


HVERFORD

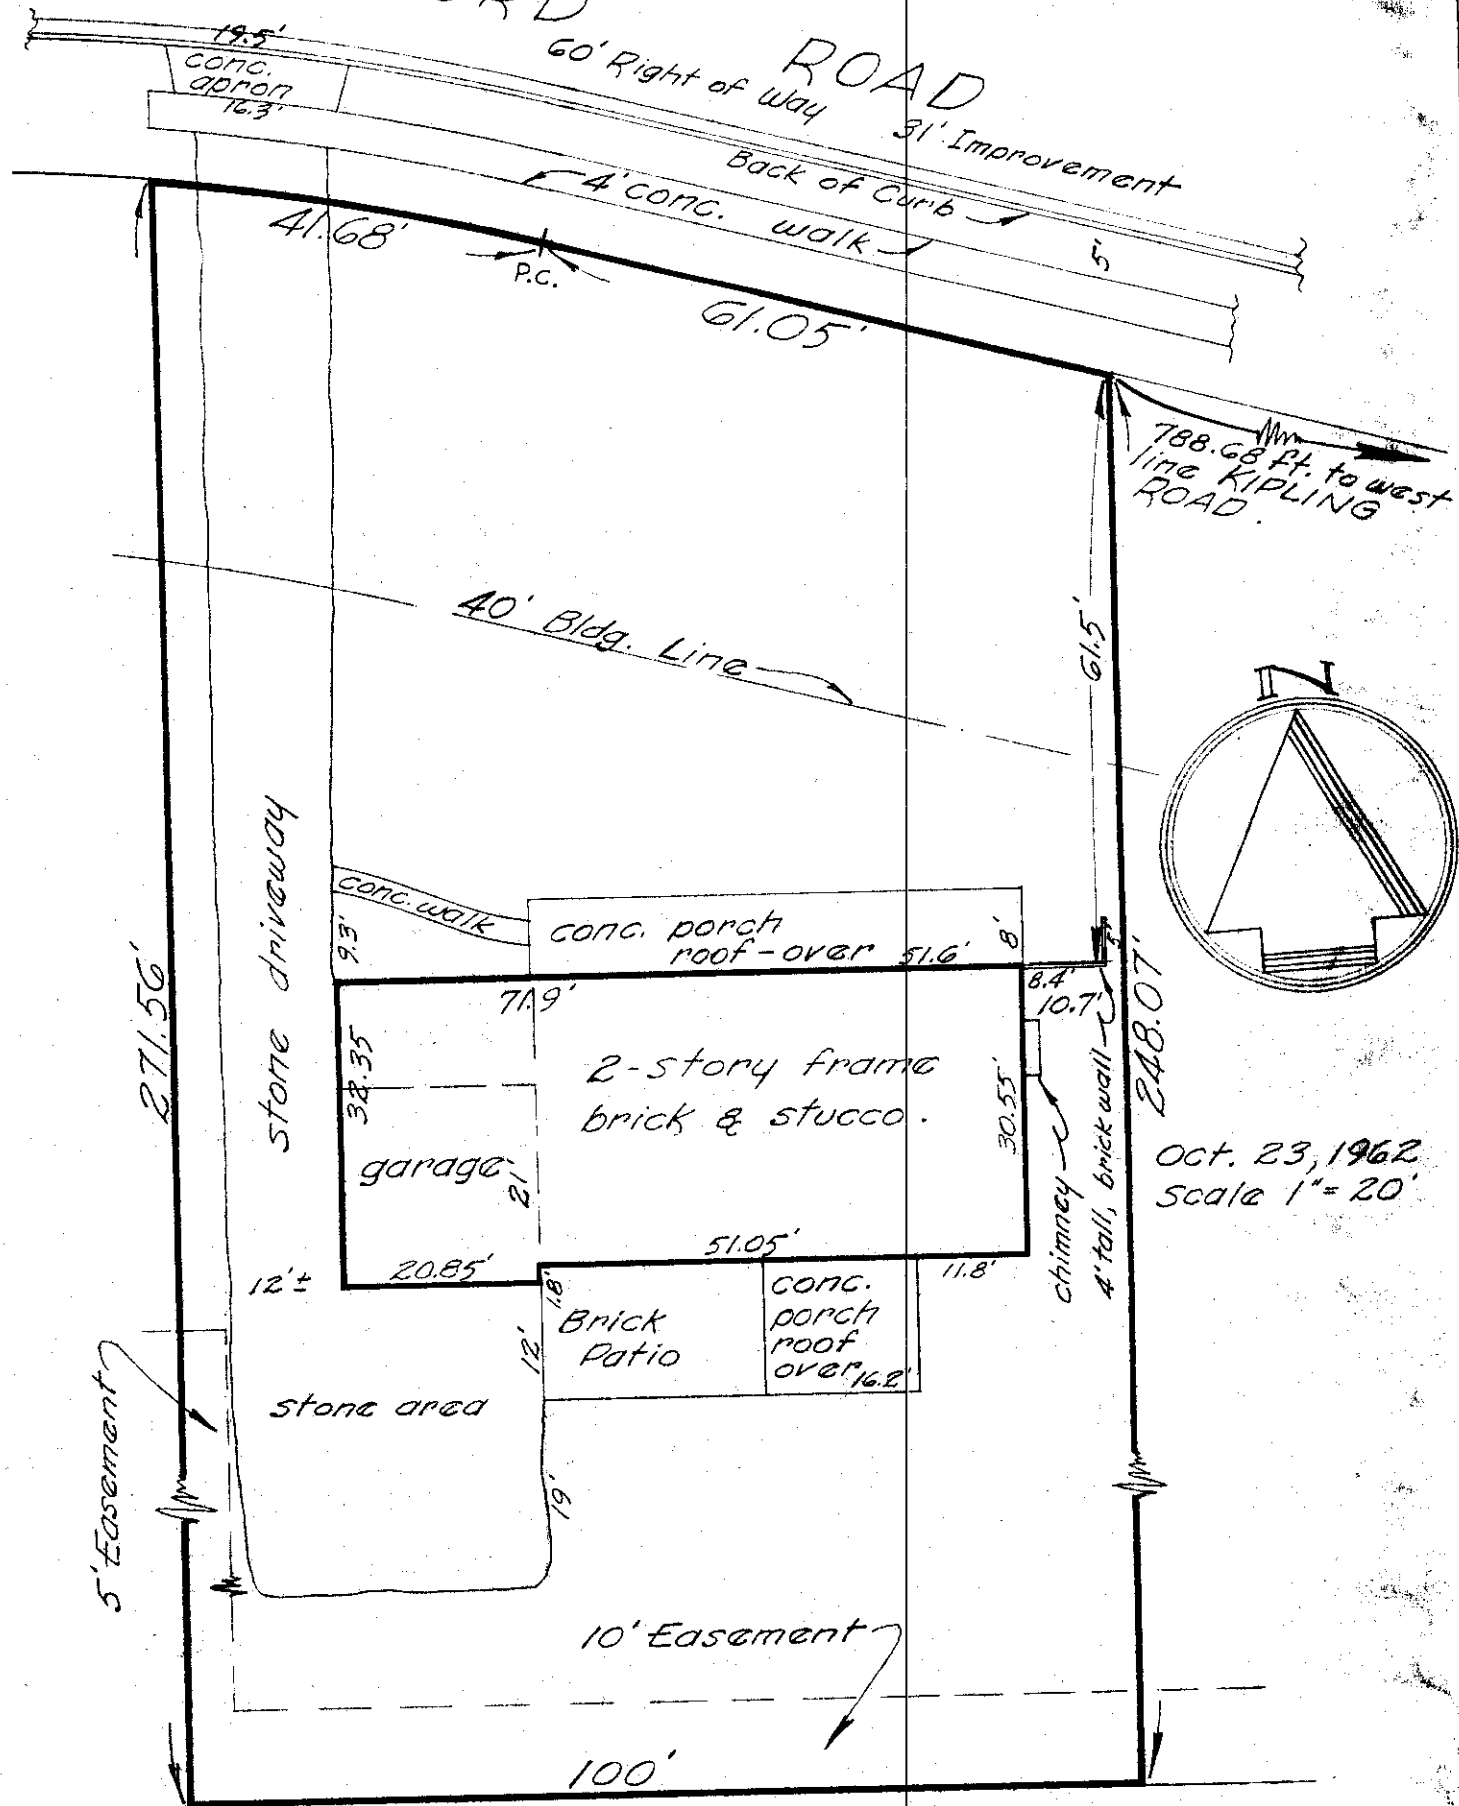

2661 HVERFORD ROAD

City of Upper Arlington, Franklin County, Ohio.

Gallbreath Mortgage Company.

Re: James J. Jentgen.

~ Blue Print Survey ~

I hereby certify that I have prepared the above plat from survey and inspection of herein described premises, and existing conditions are as shown above. Being LOT 5 of KIPLING FOREST EXTENSION NO. 1, of record in Plat Book 33, pg. 95, Recorder's Office, Franklin County, Ohio.

Harry L. Greene

Harry L. Greene, Reg. Surveyor - No. 4058.

63-10-62