


160.52' + to
GAVIN LANE.

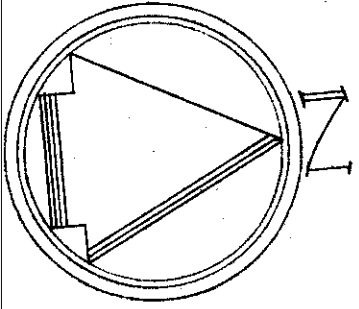

Mar. 28, 1963
Scale 1" = 20'

28-03-63

4220 MOUNTVIEW ROAD

City of Upper Arlington, Franklin County, Ohio.
WILLIAMSBURG HOMES INC. & THE KISSELL COMPANY
James M. & Jean M. McCormick

BLUE PRINT SURVEY

I hereby certify that I have prepared the above plat from
survey and inspection of herein described premises, and
existing conditions are as shown above.
Said Lot No. 7 of WILLIAMSBURG ESTATES, of record
Plat Book 34, pg. 62, Recorder's Office, Franklin
County, Ohio.

Harry L. Greene

Harry L. Greene, Reg. Surveyor - No. 4058.