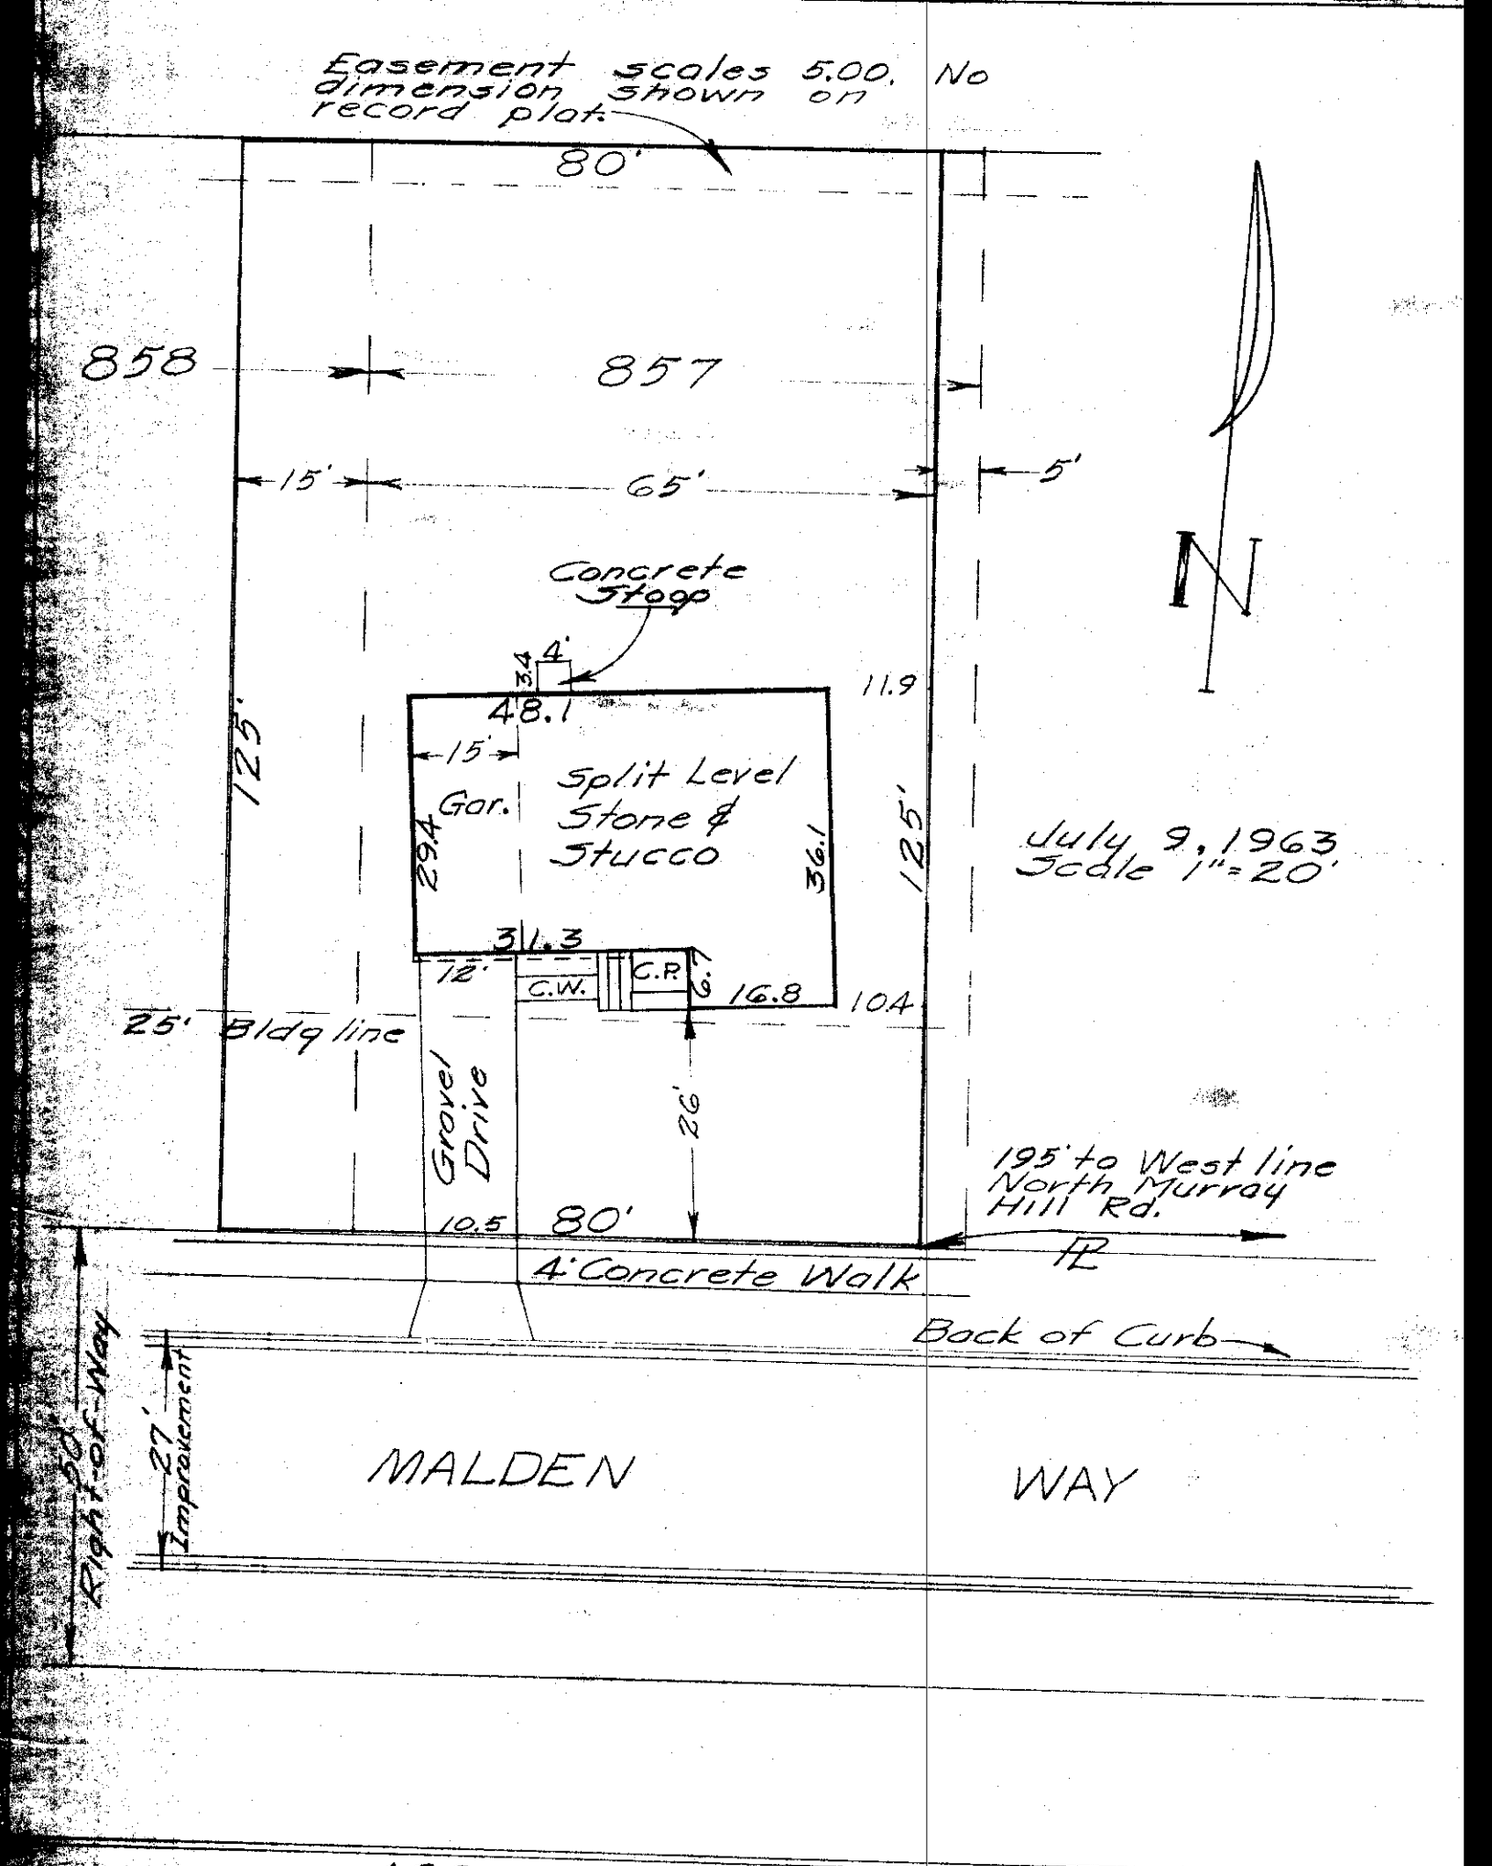

4900 MALDEN WAY
Prairie Township, Franklin County, Ohio.
Colbreath Mortgage Co.
Re: Norman F. DeVictor

~ BLUE PRINT SURVEY ~

I hereby certify that I have prepared the above plat from survey and inspection of herein described premises, and existing conditions are as shown above. Being Lot No. 857 excepting 5.00 off East side thereof and including 15.00 ft off east side Lot No. 858, of Lincoln Village, Plat Book 26, page 3 to 8, inclusive, Recorder's Office, Franklin County, Ohio.

Harry L. Greene

Harry L. Greene, Reg. Surveyor No. 4058.

09-07-63A