

KENNY

Rd. →
ROAD

20' PLANTING

STRIP

SERVICE

DRIVE

Back of Curb

20'

85.01'

Blacktop Dr.

97.51' to
KENLEY AVE.

30' Bldg. Line

3' conc. walk

Planter

11.5'

3.5'

16'

split level frame,
brick & stucco. garage

128.05'

24.1'

68.2'

garage

8.3'

18'

24.1'


26.10'

12' conc. patio

24'

4.5'

conc. walk

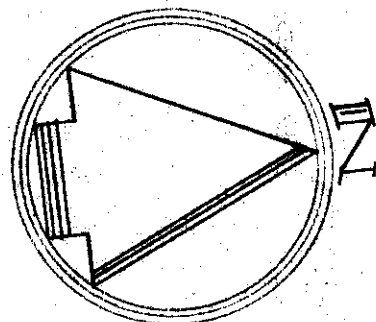

July 26-63
Scale 1"=20'

10' Easement

20'
85.00'

4184 KENNY ROAD

City of Columbus, Franklin County, Ohio.
Galbreath Mortgage Company.
Re: Glenn C. Ellison

Blue Print Survey

I hereby certify that I have prepared the above plat from survey and inspection of
herein described premises, and existing conditions are as shown above.
Being LOT NO. 70, of FOXCROFT NO. 2,
of record in Plat Book 34, pg. 7, Recorder's Office, Franklin County, Ohio

Harry L. Greene

26-07-63

Harry L. Greene - Reg. Surveyor, No. 4058