


Re: Middlesworth.

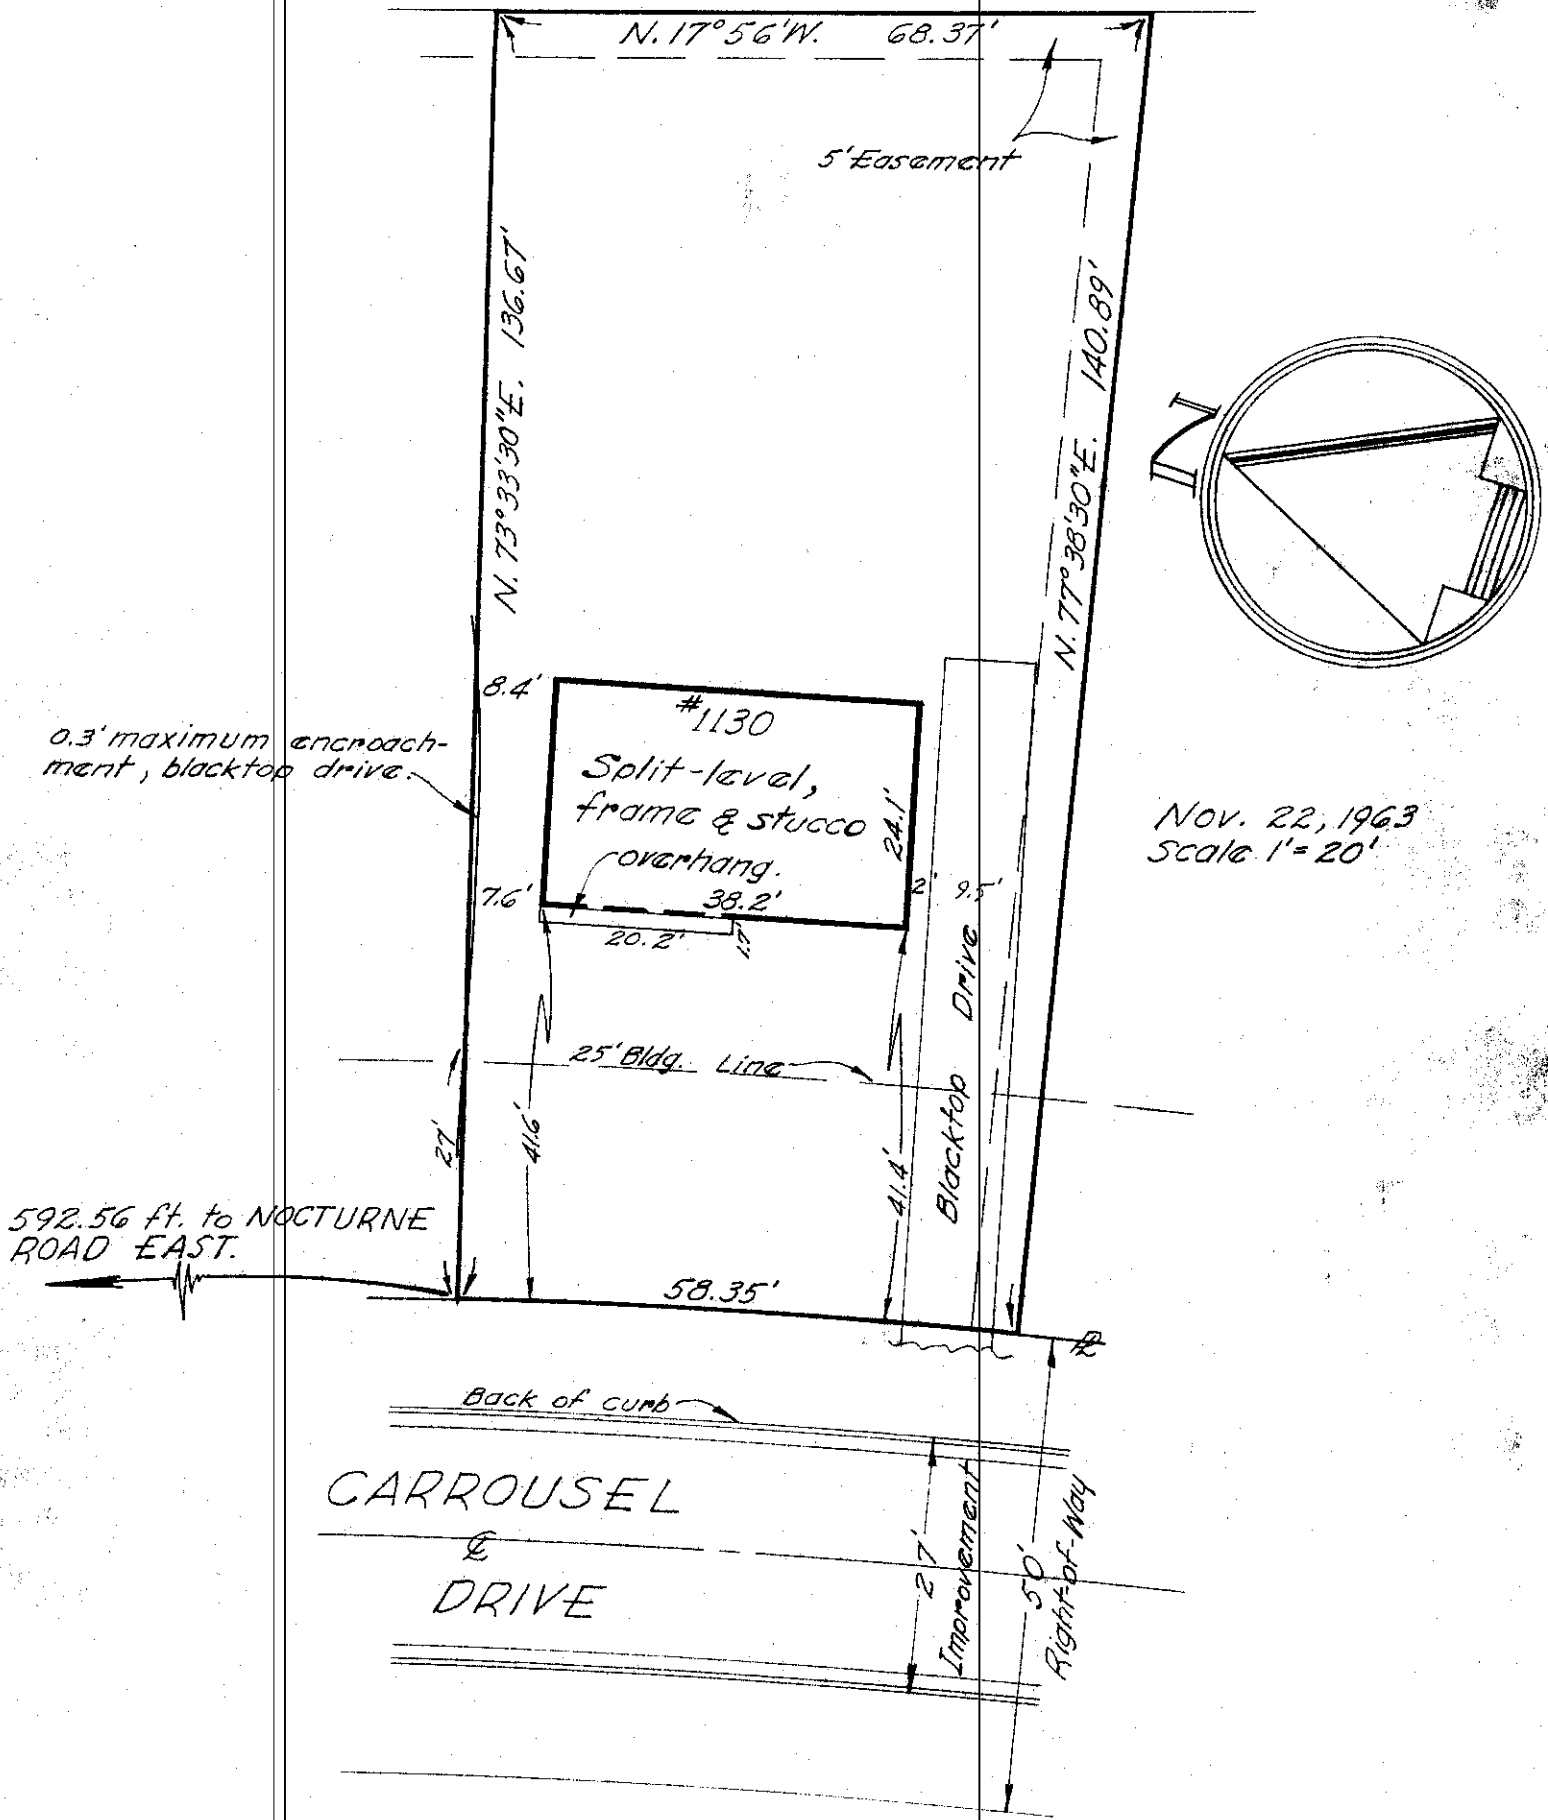

CARROUSEL
&
DRIVE

1130 CARROUSEL DRIVE

City of Reynoldsburg, Franklin County, Ohio.
INTER-COUNTY TITLE GUARANTY & MORTGAGE COMPANY.
Jay F. Zook Inc. Re: Middlesworth.

~ Blue Print Survey ~

I hereby certify that I have prepared the above plat from survey and inspection of herein described premises, and existing conditions are as shown above. Being Lot No. 141 of BRIARCLIFF NO. 1, of record in Plat Book 31, pg. 17, Recorder's Office, Franklin County, Ohio.

Harry L. Greene
Harry L. Greene, Reg. Surveyor - No. 4058. 22-11-63