
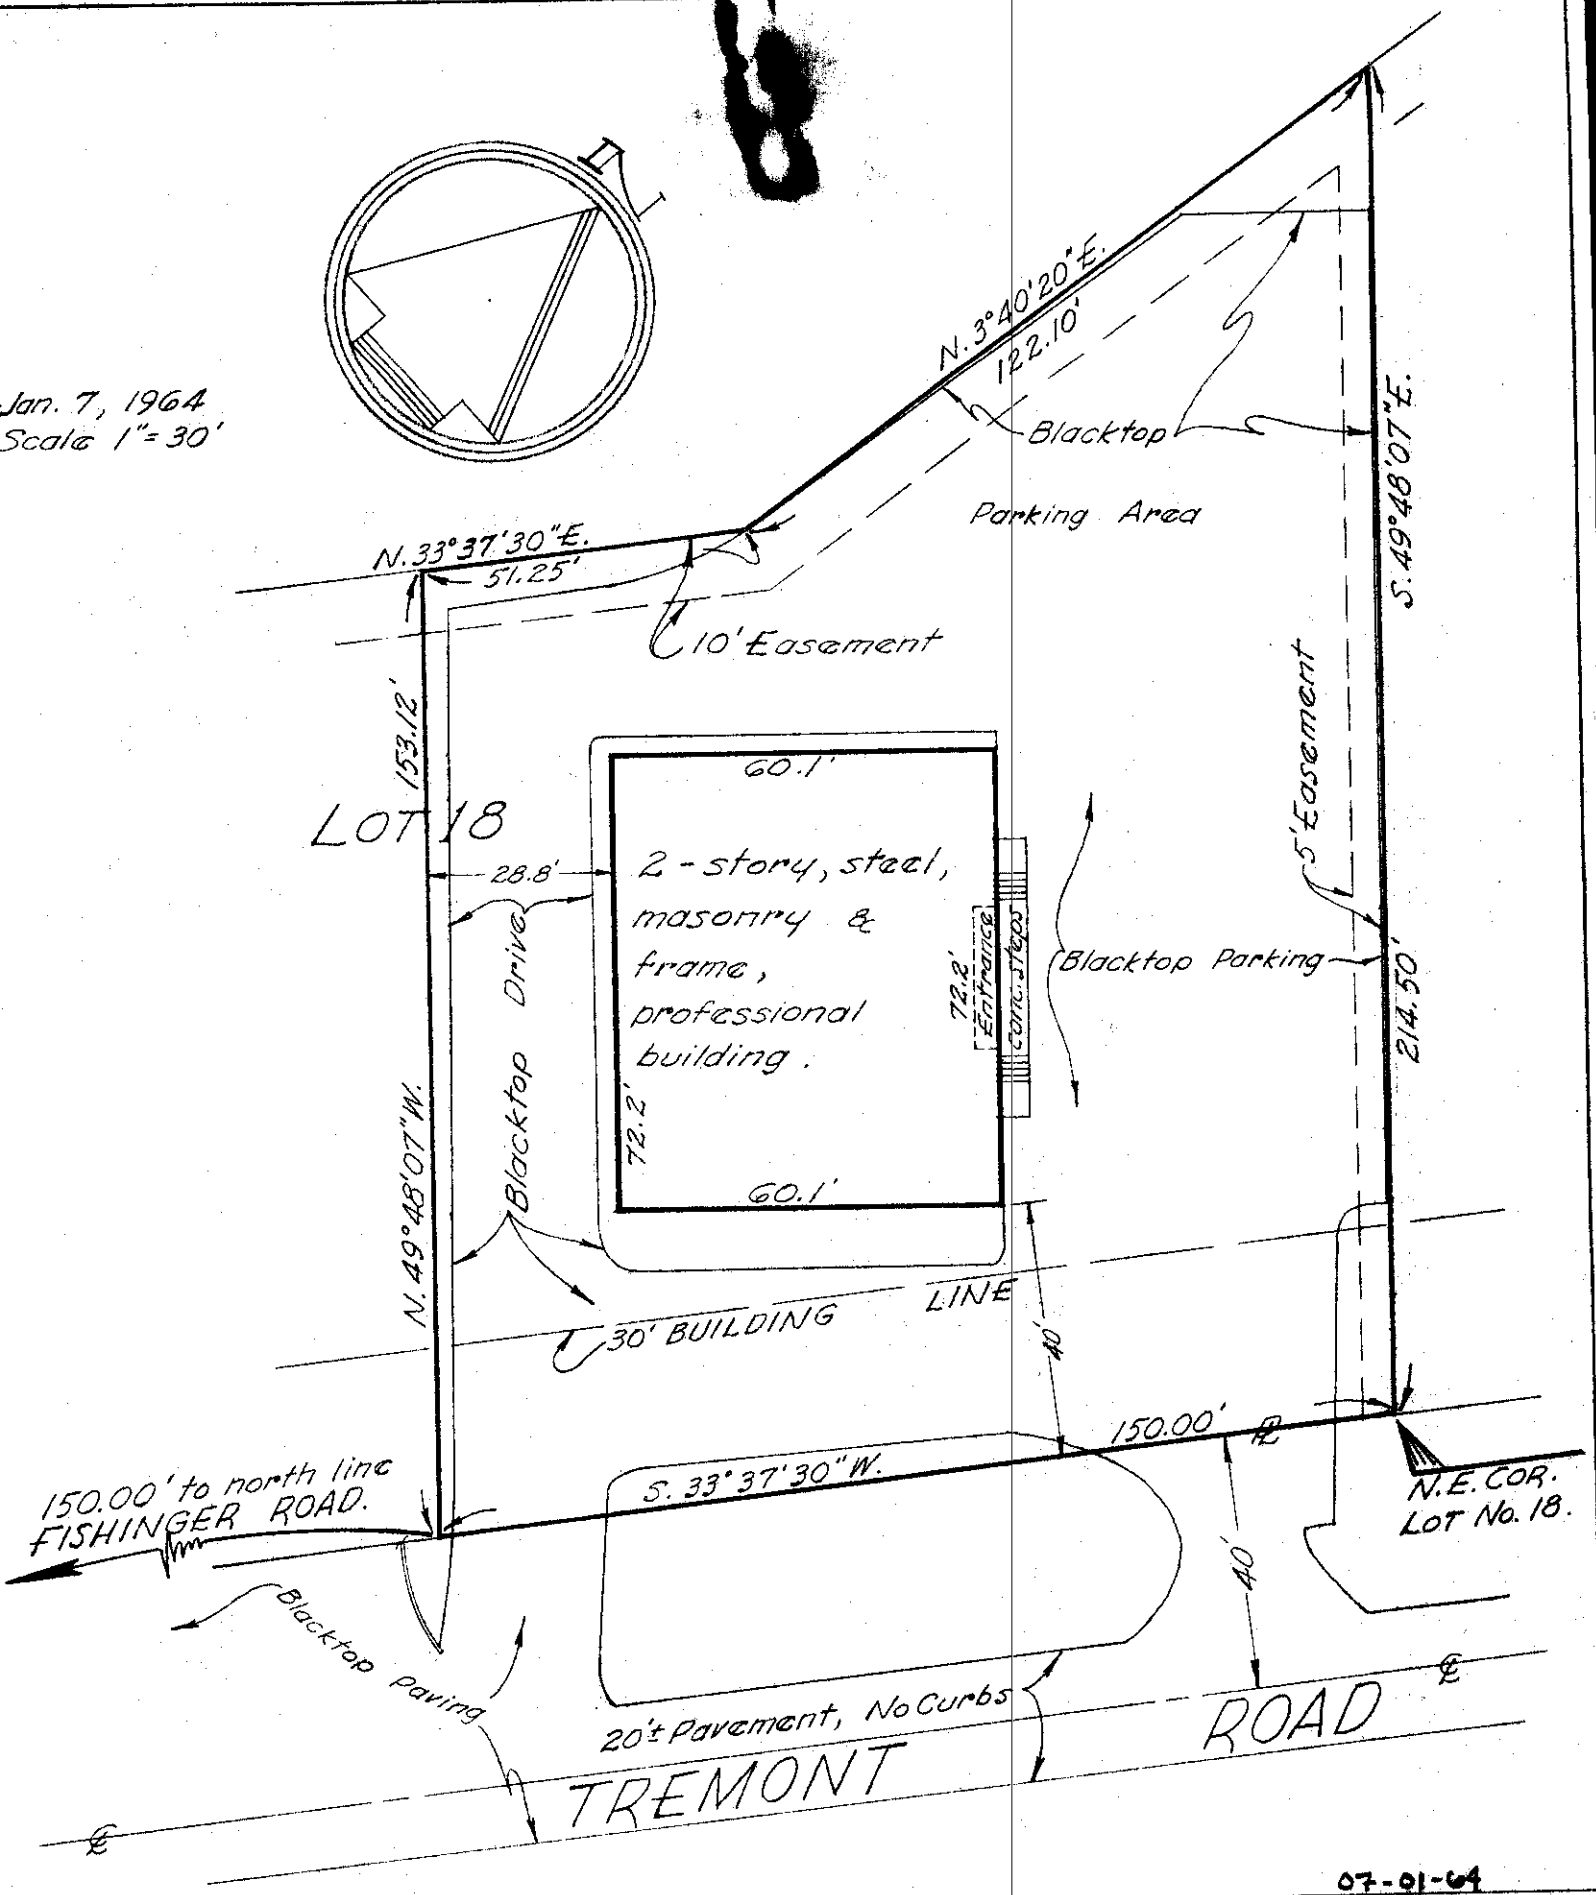


Jan. 7, 1964
Scale 1" = 30'

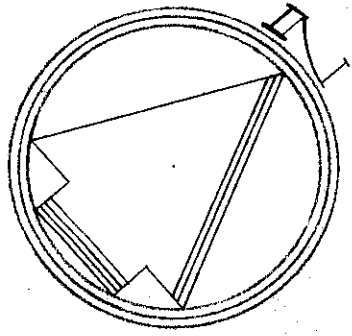

07-01-64

3363 TREMONT ROAD

City of Upper Arlington, Franklin County, Ohio.
CONNECTICUT GENERAL LIFE INSURANCE COMPANY.
TREMONT PROFESSIONAL BUILDING
BLUE PRINT SURVEY

I hereby certify that I have prepared the above plat from survey and inspection of herein described premises and existing conditions are as shown above.

The above shown property being more particularly described as per attached description.

Harry L. Greene

Harry L. Greene, Reg. Surveyor - No. 4058.