

FISHINGER

ROAD

80' Right-of-Way

South Edge of Pavement  
No Curbs.

gravel

30'

60'

14.5'

310' to MOUNTVIEW ROAD.

Drive

35' Bldg. Line

134.25'

71'

3 Board fence

conc. stoop

26.65'

18.75'

9.4'

conc.

planter

51.5'


Chimney

Patio this area.

Blocktop

134.57'

March 13, 1964  
Scale 1" = 20'

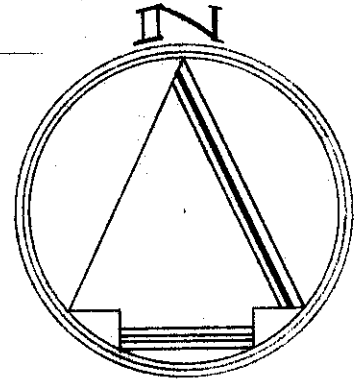

3 Board fence  
encroaches into  
adjacent property  
0.6', this area.

1-floor frame  
& conc. block

garage

24.35'

7.8'

10.5'

41.67'

3 Board fence

60'

10' Easement

B-03-64A

### 2175 FISHINGER ROAD

City of Upper Arlington, Franklin County, Ohio.  
Galbreath Mortgage Company.

Re: James R. Castell.

~ Blue Print Survey ~

I hereby certify that I have prepared the above plat from survey and inspection of herein described premises, and existing conditions are as shown above.

Being Lot No. 14, Block 32 of RIVER RIDGE ADDITION, of record in Plat Book 19, pgs. 2, 3 & 4 Recorder's Office, Franklin County, Ohio.

*Harry L. Greene*

Harry L. Greene, Reg. Surveyor - No. 4058.