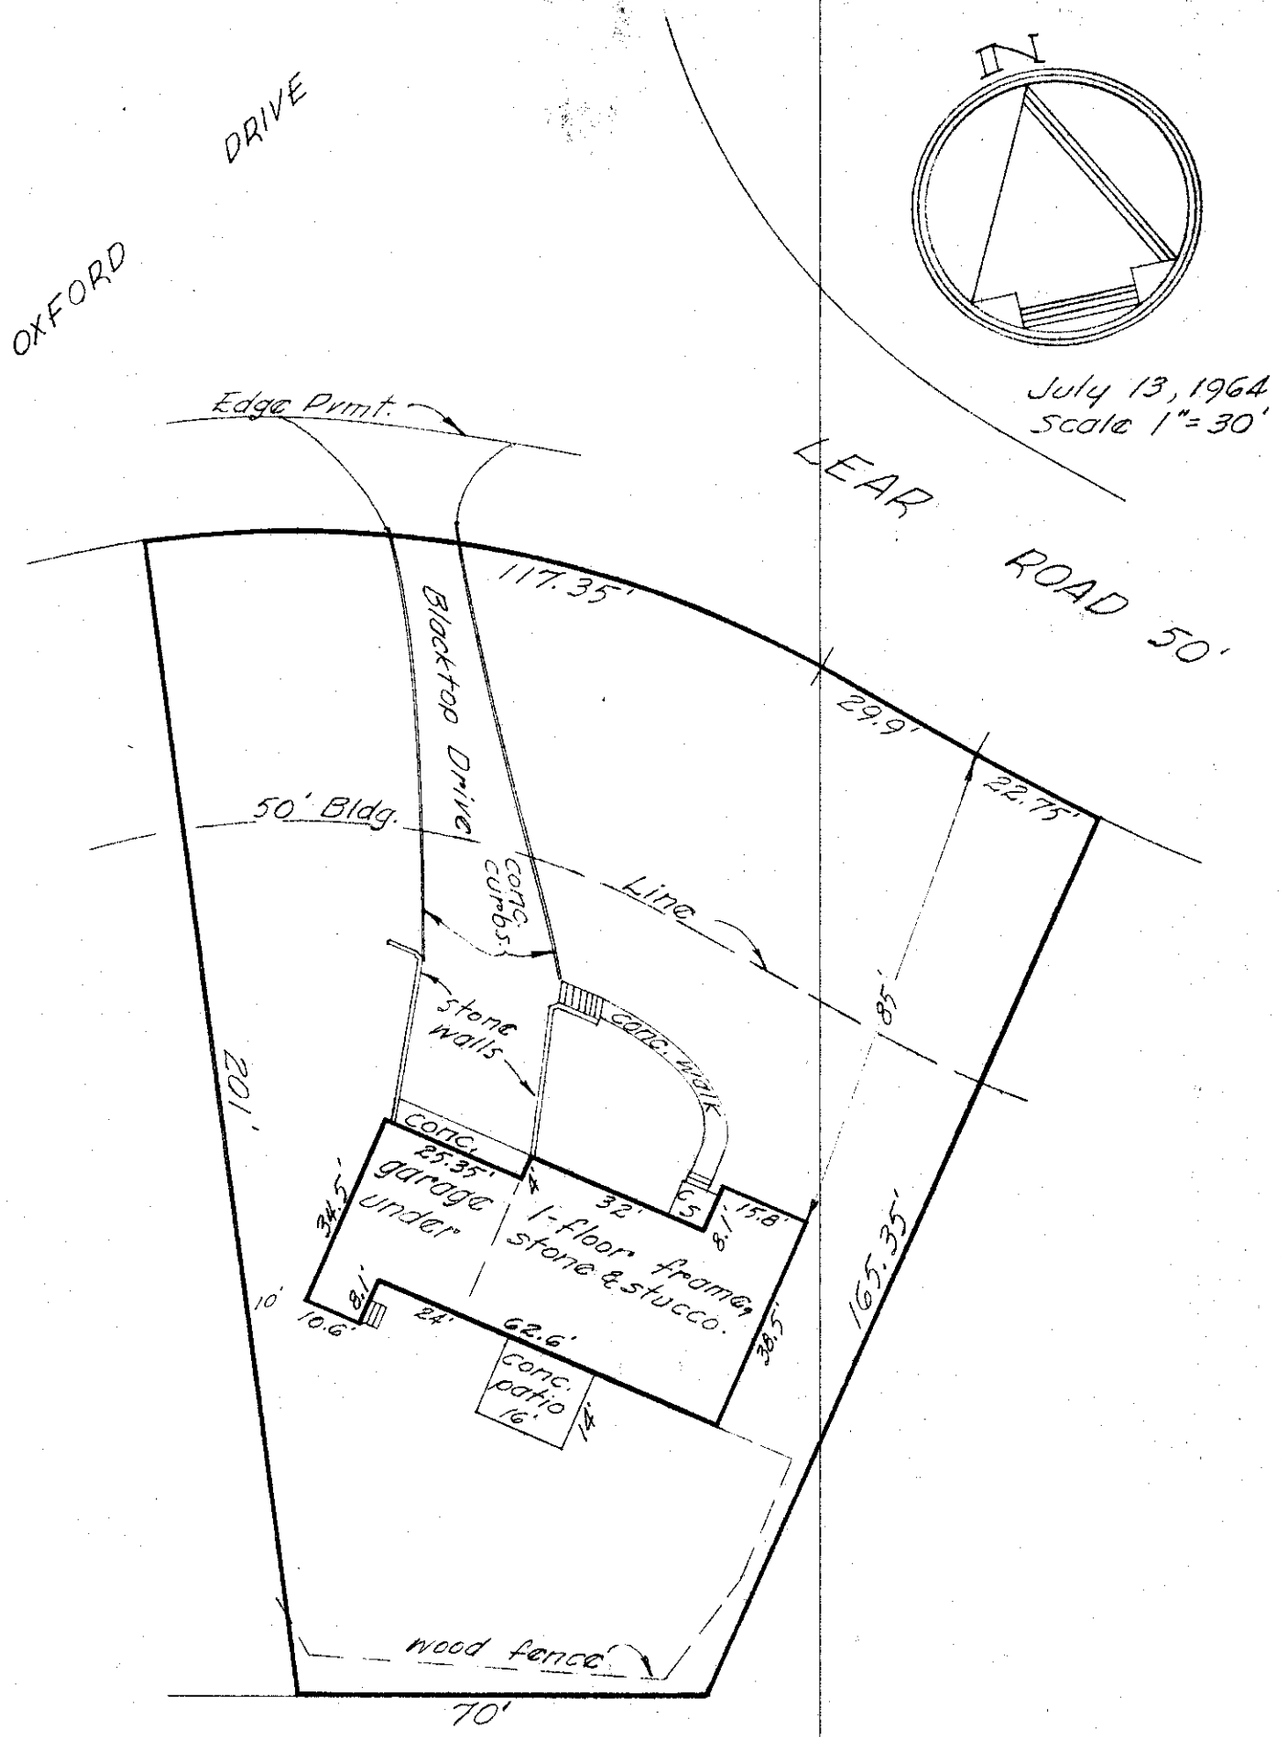

2775 LEAR ROAD
City of Upper Arlington, Franklin County, Ohio.
Galbreath Mortgage Company.
Re: Hasip Temizer
~ Blue Print Survey ~

I hereby certify that I have prepared the above plat from survey and inspection of herein described premises, and existing conditions are as shown above.
Being Lot No. 9, of FAIRFAX, a subdivision of record in Plat Book 19, pg. 60, Recorder's Office, Franklin County, Ohio.

Harry L. Greene

13-07-64B

Harry L. Greene, Reg. Surveyor - No. 4058.