


Oct. 5-1964 FINAL  
 Scale 1"=20' Dec. 30-1964

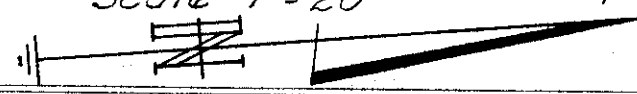

**240 LARRIMER AVENUE**

City of Worthington, Franklin County, Ohio.  
 Galbreath Mortgage Company.  
 Re: Robert D. Clinger.

~ Blue Print Survey ~

I hereby certify that I have prepared the above plat from survey and inspection of herein described premises and existing conditions are as shown above.

Being LOT 4, Block "J", of WORTHINGTON ESTATES, of record in Plat Book 33, pages 38-39-40, Recorder's Office, Franklin County, Ohio.

*Harry L. Greene*

Harry L. Greene, Reg. Surveyor - No. 4058.

30-10-64C