


HOLLY AVE. 50'

16' Alley

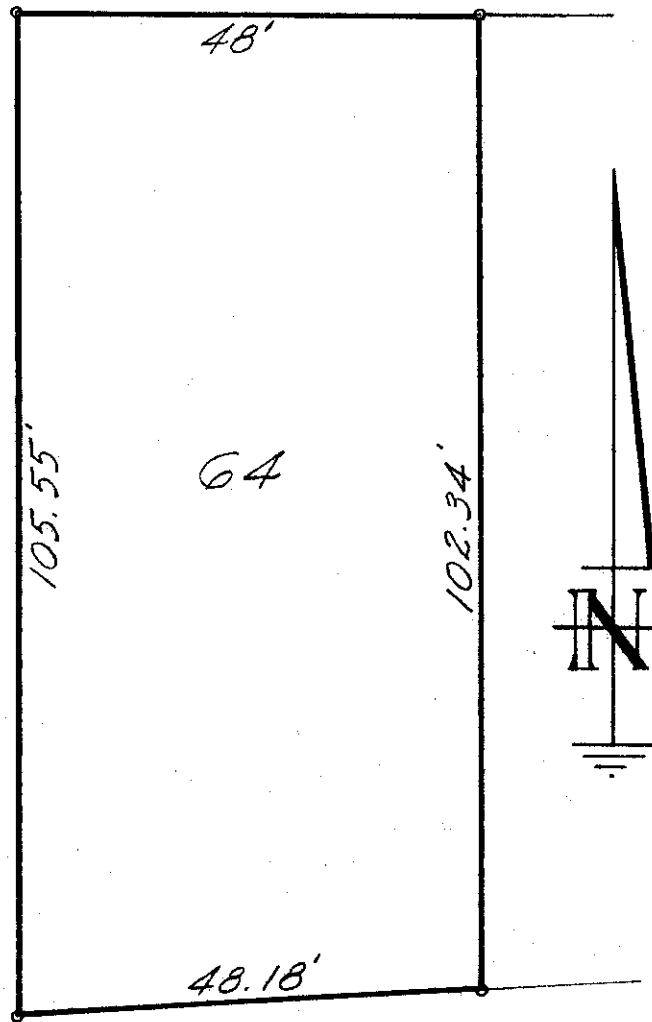

$\Delta = 7^{\circ}36'$ $ER = 4940$ $T = 328.11$

SECOND

AVE. 50'

Map showing LOT 64 of NORTHWEST BOULEVARD PLAT NO. 5, City of Grandview Heights, Ohio, of record in Plat Book 14, pg. 30, Recorder's Office, Franklin County, Ohio, as surveyed by me July 12, 1965.

Harry L. Greene

12-07-65C

Harry L. Greene, Reg. Surveyor - No. 4058.