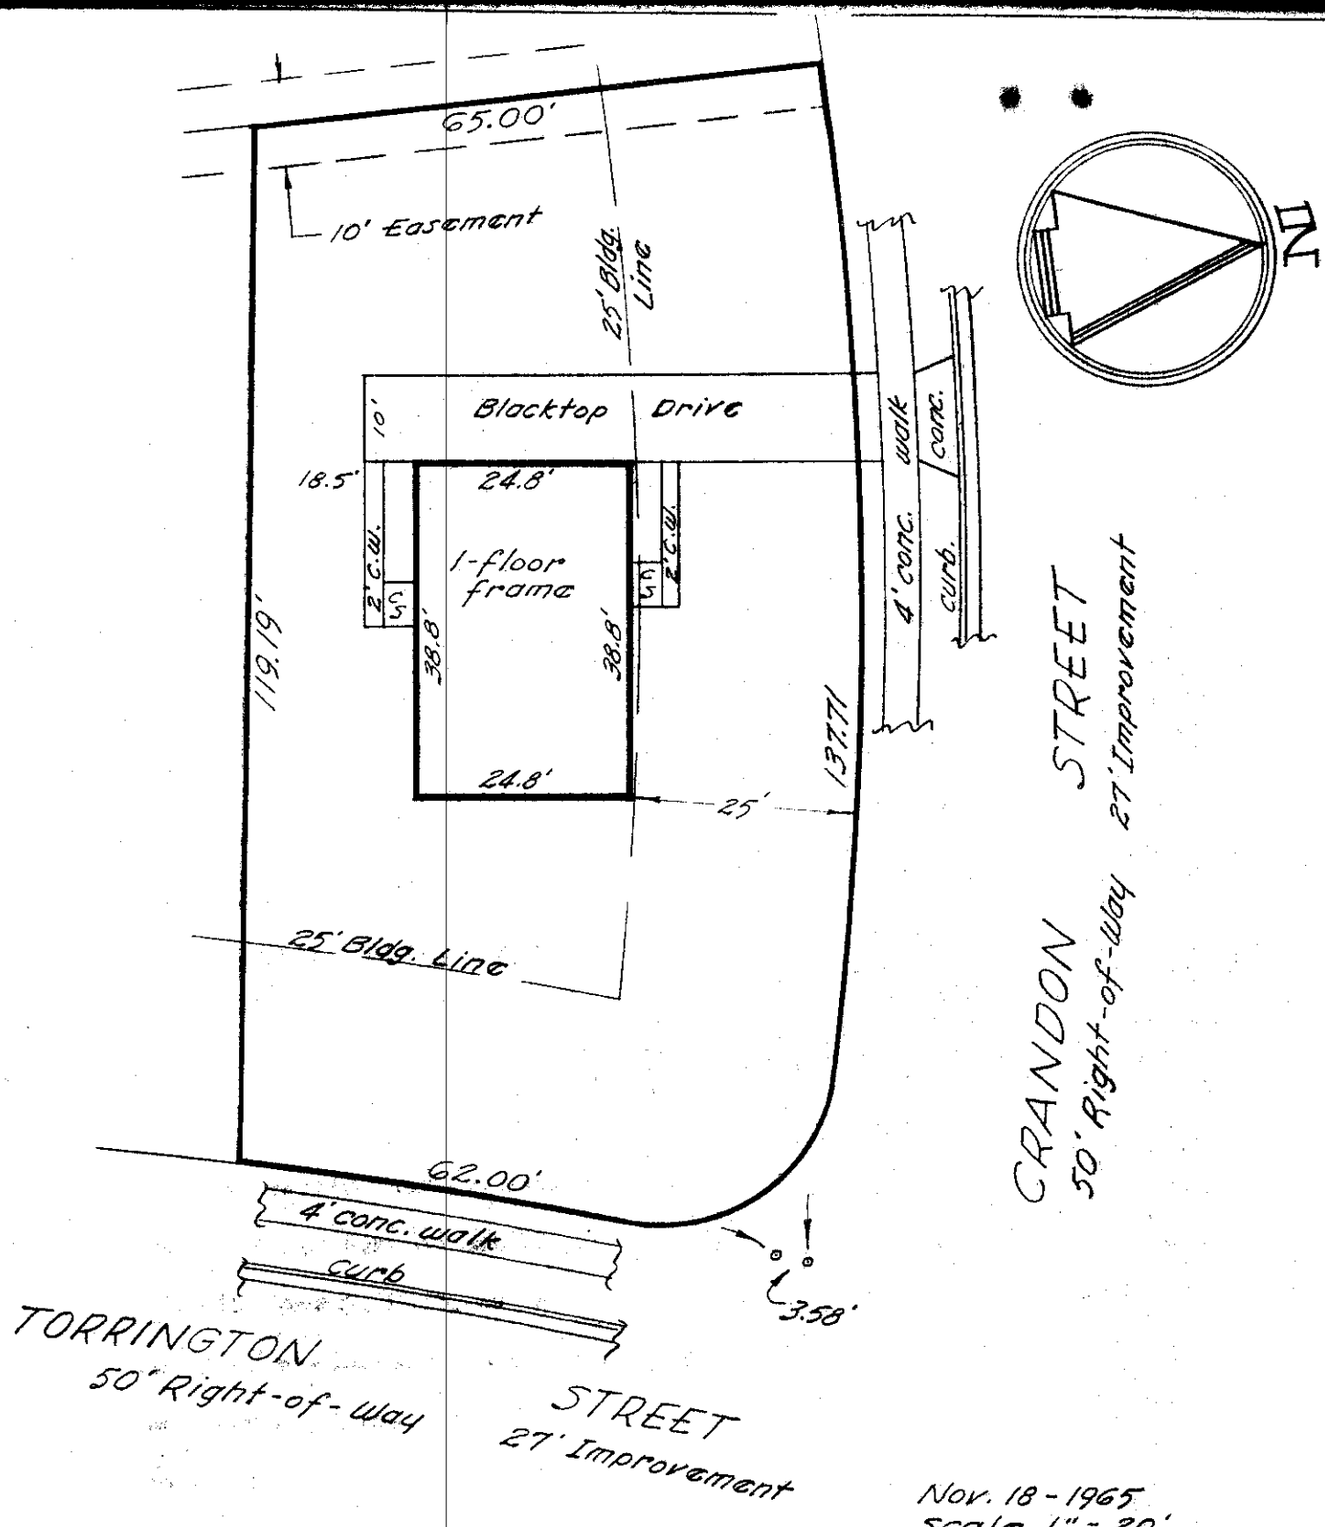

Nov. 18 - 1965
Scale 1" = 20'

3193 CRANDON STREET
NORWICH TOWNSHIP, FRANKLIN COUNTY, OHIO.
Galbreath Mortgage Company.
Re: Paul Lehman

~ Blue Print Survey ~

I hereby certify that I have prepared the above plat from survey and inspection of herein described premises and existing conditions are as shown above. Being Lot No. 154 of BEACON SECOND SUBDIVISION of record in Plat Book 31, pg. No. 5, Recorder's Office, Franklin County, Ohio.

Harry L. Greene 18-11-65 B

Harry L. Greene, Reg. Surveyor - No. 4058.