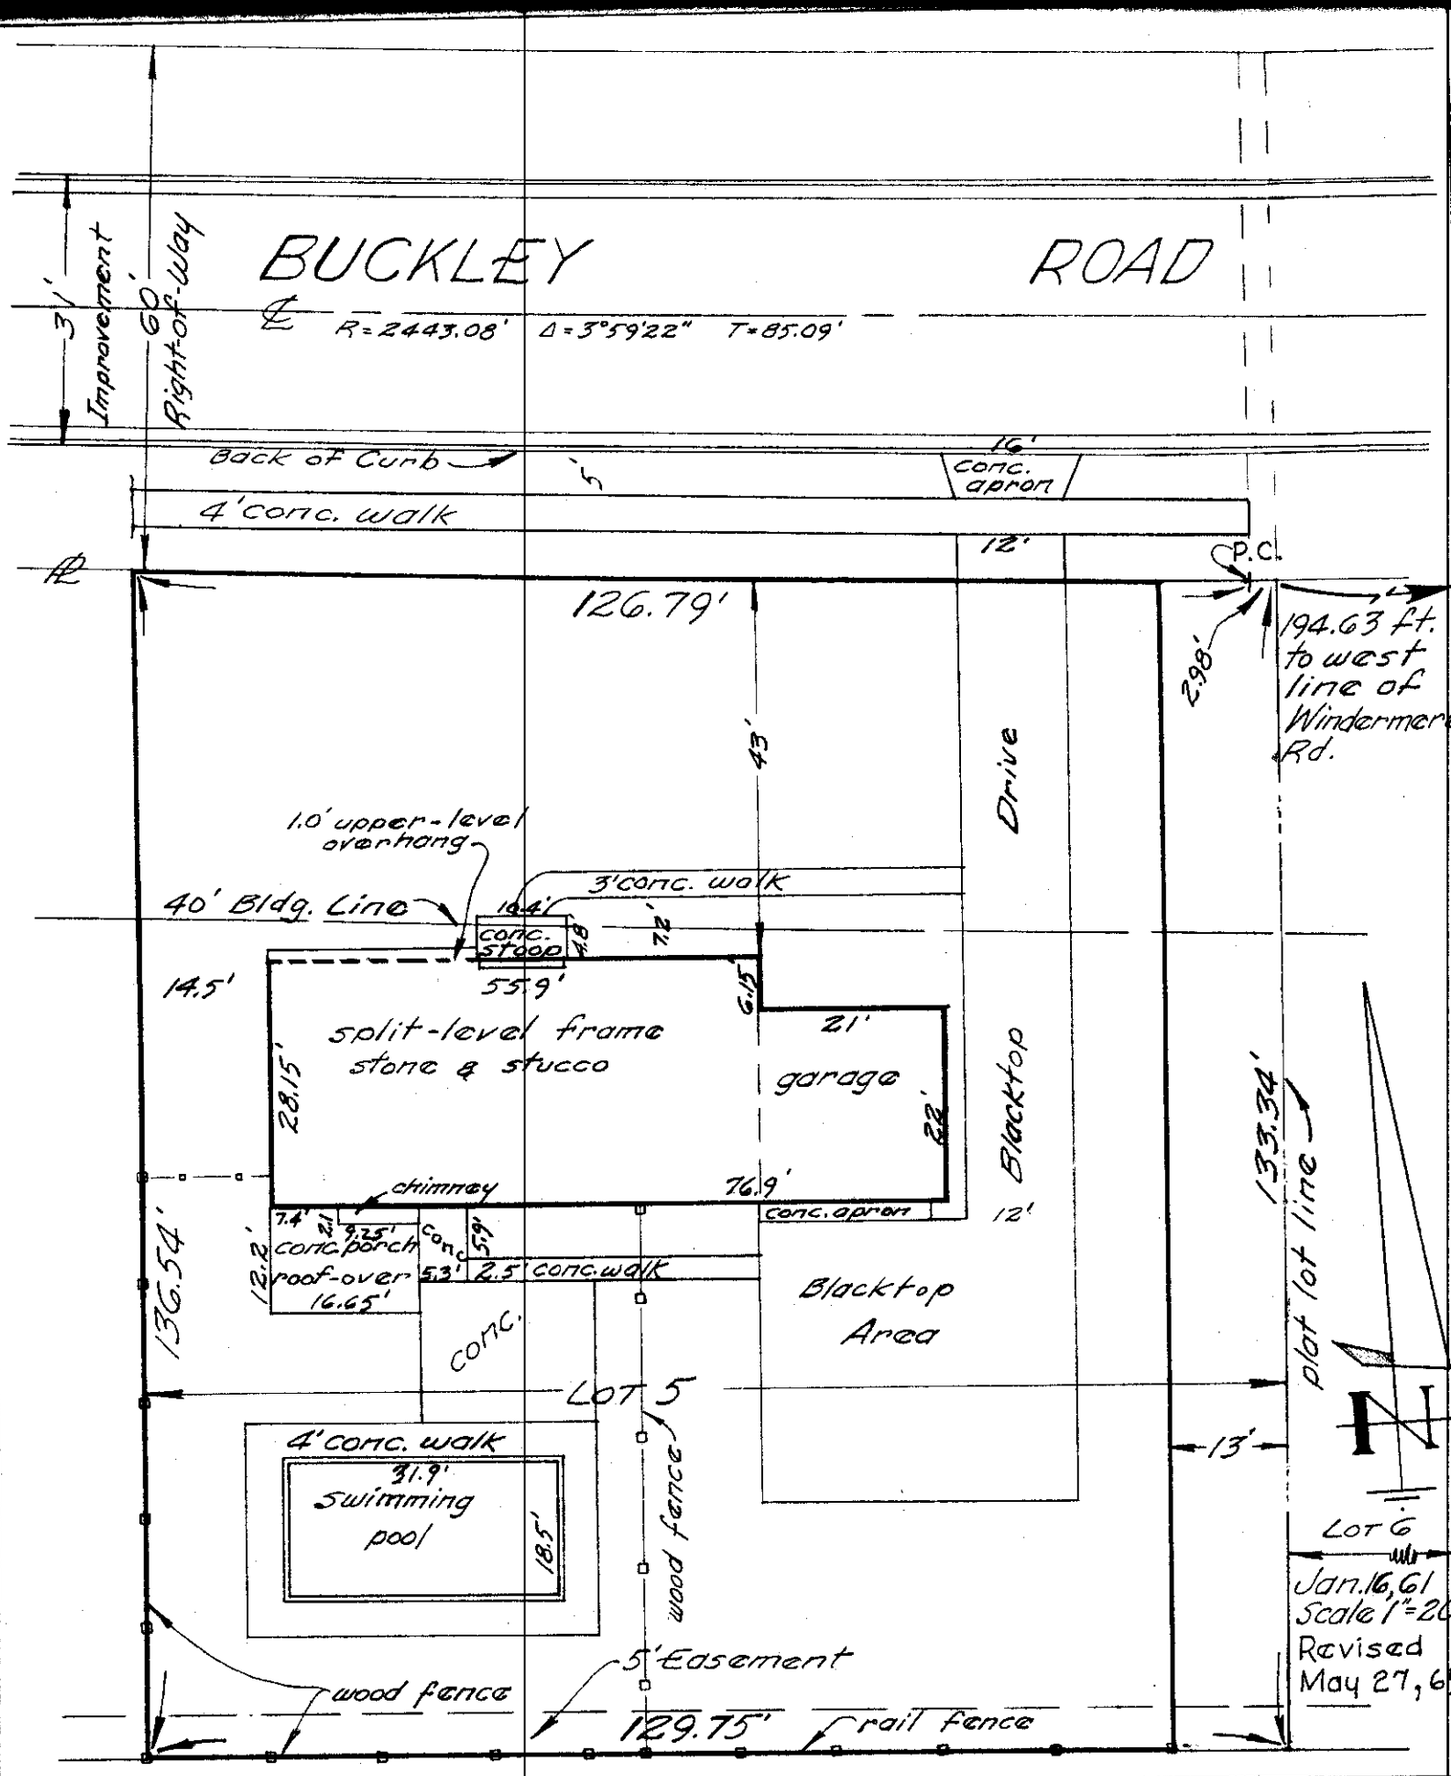

2415 BUCKLEY ROAD
City of Upper Arlington, Franklin County, Ohio.
Galbreath Mortgage Company.
Re: Richard F. Tousley.

~ Blue Print Survey ~

I hereby certify that I have prepared the above plat from survey and inspection of herein described premises and existing conditions are as shown above.

Being Lot No. 5, Block 5, of MIDDLESEX PLACE No. 2, of record in Plat Book 30, pages 30-31, Recorder's Office, Franklin County, Ohio, Except 13.0 ft. off of the east side thereof.

Harry L. Greene 27-05-65B

Harry L. Greene, Reg. Surveyor - No. 4058.