



June 24-65
Scale 1" = 20'

20' Alley

155.2'

52.5'

254


253

94

252

155.2'

251

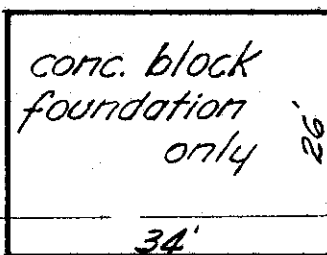


93

250

52.5'

152.50 ft. to GLENMAWR AVE.

WETMORE

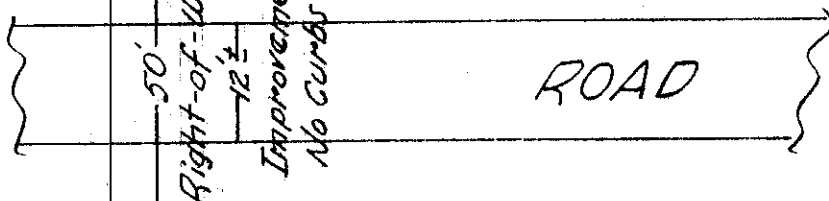

854 WETMORE ROAD

City of Columbus, Franklin County, Ohio.
Galbreath Mortgage Company.

Re: Archer McConnel

~ Blue Print Survey ~

I hereby certify that I have prepared the above plat from survey and inspection of herein described premises and existing conditions are as shown above. Being more particularly described as per attached copy. Harry L. Greene

Harry L. Greene, Reg. Surveyor - 4058

24-06-65.B