


# WESTMOOR PLACE

27' Improvement

50' Right-of-Way

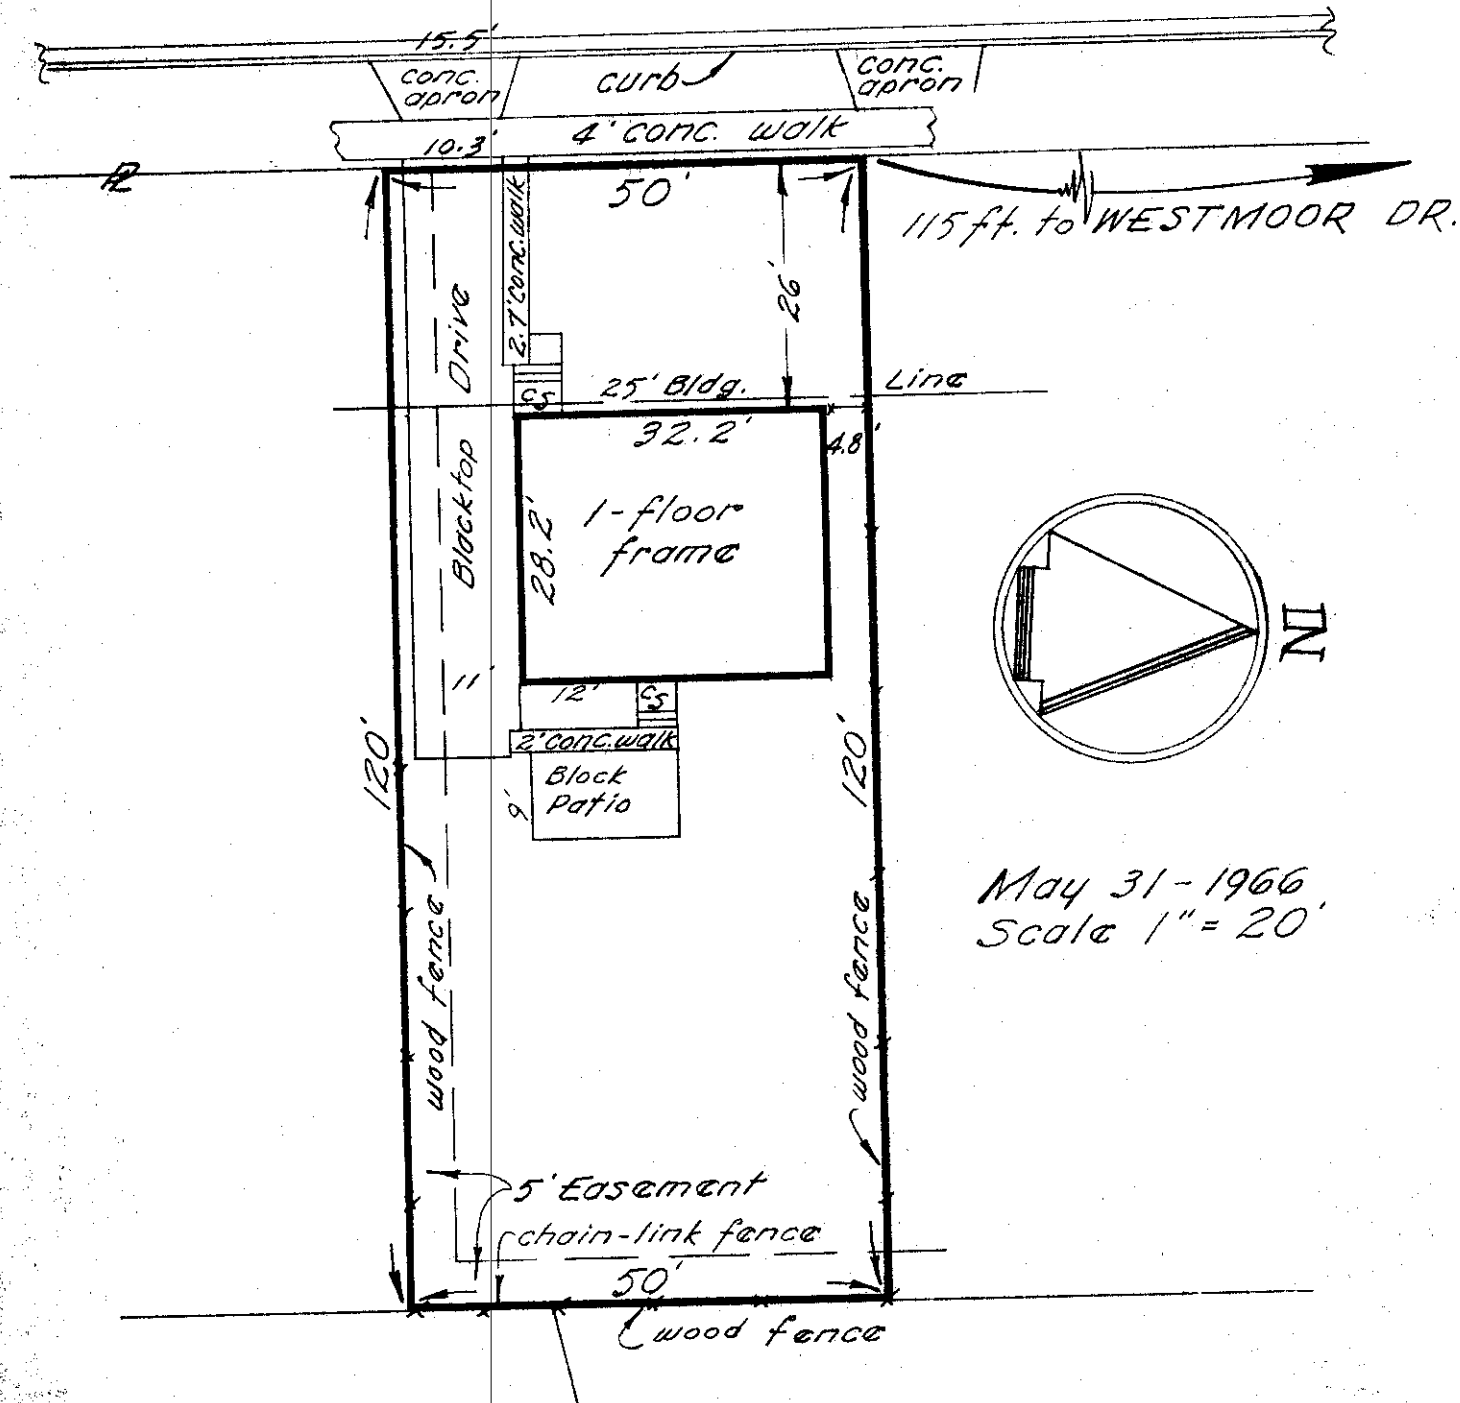

## 500 WESTMOOR PLACE

City of Columbus, Franklin County, Ohio.

Galbreath Mortgage Company.

Re: Robert & Phyllis Krotky.

~ Blue Print Survey ~

I hereby certify that I have prepared the above plat from survey and inspection of herein described premises and existing conditions are as shown above. Being Lot 138 of VALLEYVIEW HEIGHTS No 2, of record in Plat Book 31, pg. 10, Recorder's Office, Franklin County, Ohio.

*Harry L. Greene*

Harry L. Greene, Reg. Surveyor - No. 4058.