


75 ft. to MOUNT-VIEW ROAD.

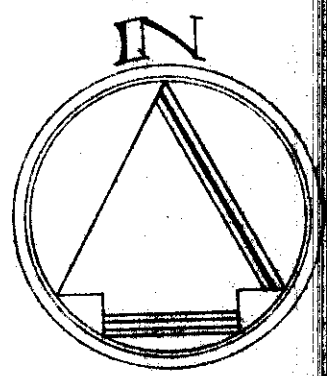

Nov. 3, 1966
Scale 1" = 20'

2267 DORSET ROAD

City of Upper Arlington, Franklin County, Ohio.
Galbreath Mortgage Company.
Agent: John F. Nuetzling.

Blue Print Survey

I hereby that I have prepared the above plat from survey and inspection of herein described premises and existing conditions are as shown above.

Being Lot No. 12, Block 209 of the PLAT OF THE NORTH PART OF BLOCKS Nos. 209 AND 210 AND THE SOUTH PART OF BLOCKS Nos 213 AND 214, CITY OF UPPER ARLINGTON, of record in Plat Book 20, pg. 62, Recorder's Office, Franklin County, Ohio.

Harry L. Greene

Harry L. Greene, Reg. Surveyor - No. 4058.

05-15-66