

SHREWSBURY

ROAD

⊕

50 ft. Right-of-Way

26' Improvement

15'

curb

8.4'

60'


Drive

concr. walk

12.8' 6.5'

Bldg. Line 35'

Blacktop

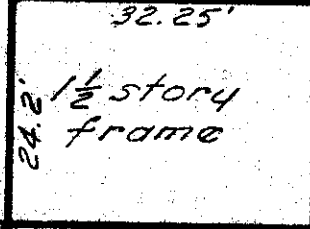

9.4' 6.5'


concr. walk

0.7'

125.00'

125.00'

184.91 ft. to MOUNTVIEW ROAD.

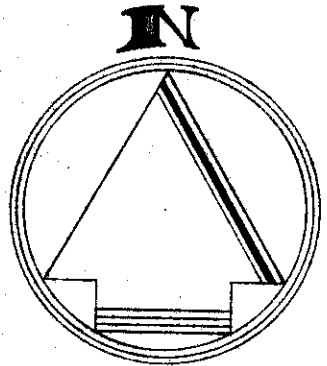

Nov. 9, 1966

Scale 1 in. = 20 ft.

wire fence

1.5'

60'

0.5'

0.5'

10' Easement

2195 SHREWSBURY ROAD

City of Upper Arlington, Franklin County, Ohio.

Re: Jack Hott.

~ Blue Print Survey ~

I hereby certify that I have prepared the above plat from survey and inspection of herein described premises and existing conditions are as shown above. Being LOT No. 16, Block 28 of RIVER RIDGE ADDITION, of record in Plat Book 19, pgs. 2-3-4, Recorder's Office, Franklin County, Ohio.

Harry L. Greene

Harry L. Greene, Reg. Surveyor - No. 4058.

09-11-66