

WESTMINSTER  
50' Right-of-Way

DRIVE  
26' Improvement


curb

15.5'

331.36' to North Star Rd.

N

July 7-1967  
Scale 1" = 20'

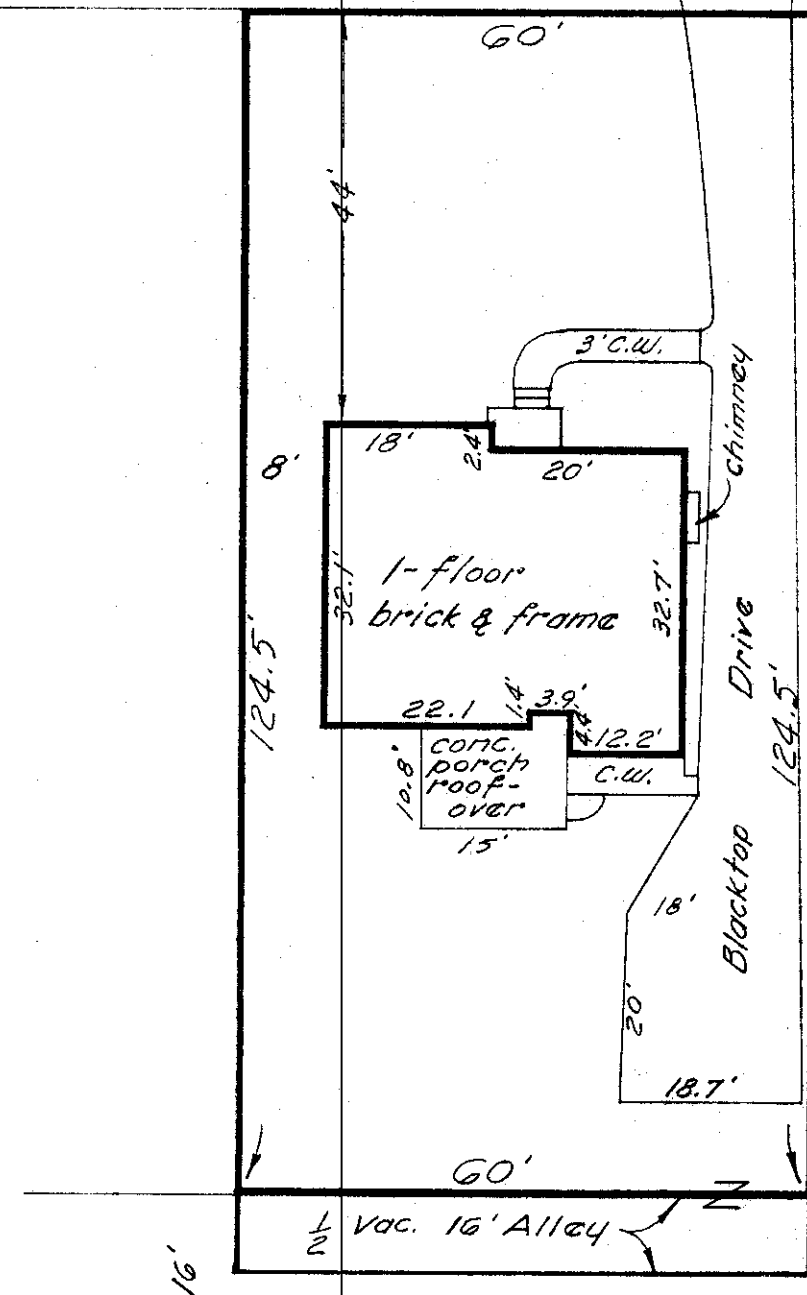

1441 WESTMINSTER DRIVE

City of Upper Arlington, Franklin County, Ohio.

Galbreath Mortgage Company.

Re: Marie Bushong.

~ Blue Print Survey ~

I hereby certify that I have prepared the above plat from survey and inspection of herein described premises and existing conditions are as shown above.

Being Lot No. 30 of COLLEGE HILL PLACE ADDITION, of record in Plat Book 16, pg. 10, Recorder's Office, Franklin County, Ohio.

Harry L. Greene

Harry L. Greene, Reg. Surveyor - No. 4058.

07-07-67A