

EDGEHILL DR.
60' Right-of-Way

97.42'
175' Bldg. Line

Roof Overhang 16.3' Balcony 5.8'

56.4'

Split level
frame & brick

12.3'
6'
11.3'
9.5'

56.4'

Roof por. 7.7' Overhang

conc. pad

stone area

frame garage

stone drive

5.6.8'

5.3'

24.1'

24.2'


3' Roof Overhang

492.85'

143'

50' Bldg. Line

520.00'

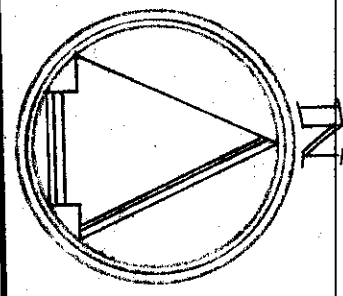

June 29, 1966
Scale 1"=20'

FINAL
Jan. 4, 1967
H.H.E.

CLAIRMONT
50' Right-of-Way

ROAD

96'

244'± to McCoy Rd.

4235 CLAIRMONT ROAD

City of Upper Arlington, Franklin County, Ohio.
Salbreath Mortgage Company.

Re: Griffing

~ Blue Print Survey ~

I hereby certify that I have prepared the above plat from survey and inspection of herein described premises and existing conditions are as shown above.

Being Lot No. 80 of FAIRFAX, of record in Plat Book 19, page 60, Recorder's Office, Franklin County, Ohio.

Harry L. Greene

04-01-67

Harry L. Greene, Reg. Surveyor - No. 4058.