



HILL CREST

EAST ST.
50' Right-of-Way 27' Improvement

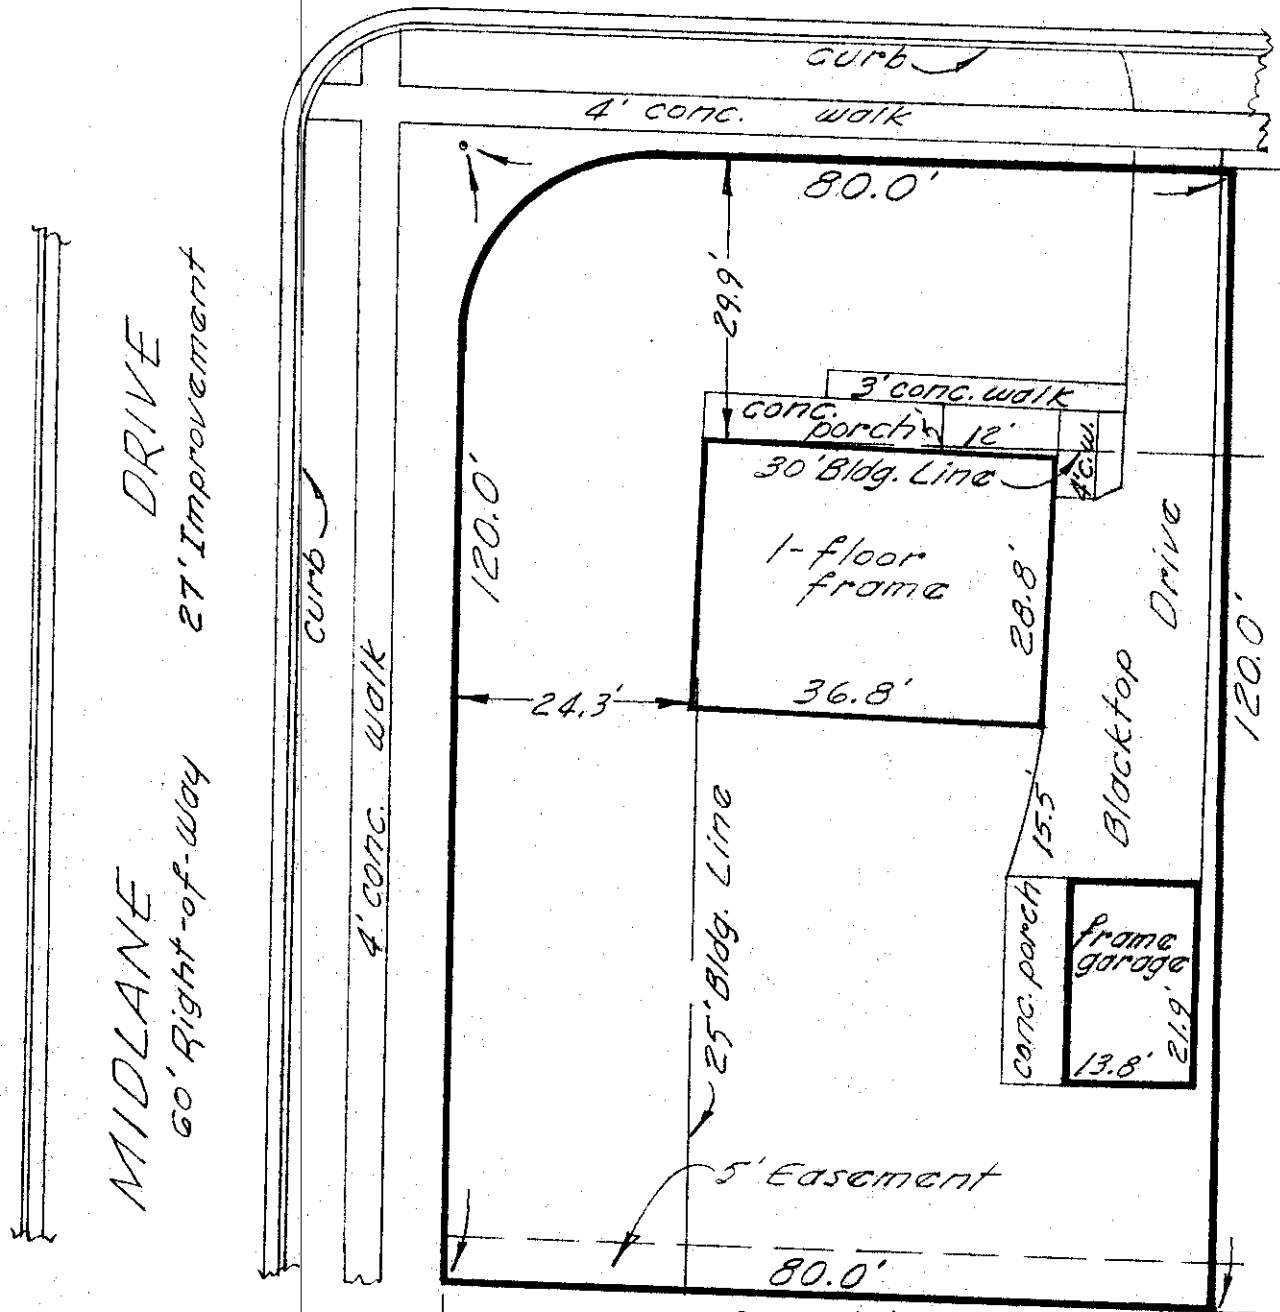

July 29-1966
Scale 1" = 20'

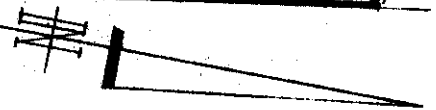

642 HILL CREST EAST ST.
City of Hilliard, Franklin County, Ohio.
Galbreath Mortgage Company.
Re: William Freeland.

~ Blue Print Survey ~

I hereby certify that I have prepared the above plat from survey and inspection of herein described premises and existing conditions are as shown above.

Being Lot No. 83 of HILLIARD HEIGHTS No. 3, of record in Plat Book 27, pg. 96, Recorder's Office, Franklin County, Ohio.

Harry L. Greene
Harry L. Greene - Reg. Surveyor No. 4058.

29-07-66