

BRANDYWINE
60' Right-of-Way

DRIVE

31' Improvement

curb

concrete apron

120 ft. to WILLOW FORGE DRIVE

walk

4' CONC.

81.35'

16'

83.57

43.5'

40' Bldg. Line


crushed stone drive

2-story frame & stucco

garage

stoop

chimney

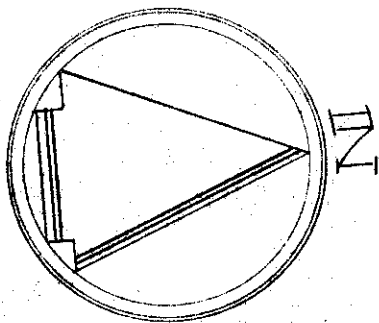

April 30 - 1966
Scale 1" = 20'
FINAL - Aug. 12, 1966

Easement Area

1950 BRANDYWINE DRIVE
City of Upper Arlington, Franklin County, Ohio.
Galbreath Mortgage Company.
Re: Van Doornevelt.

Blue Print Survey
I hereby certify that I have prepared the above plat from survey and inspection of herein described premises and existing conditions are as shown above.
Being Lot 41 of WILLOW FORGE, of record in Plat Book 36, pg. 30, Recorder's Office, Franklin County, Ohio.

Harry L. Greene - Reg. Surveyor No. 4058.

12-08-66B