


Harry L. Greene, Surveyor

2160 Tremont Center, Columbus, Ohio 43221

Plat showing survey of 0.956 acres in the name of James D. Flaherty, Jr. and Susan Jean Flaherty, as shown of record in Deed Book 3490, Page 795, Recorder's Office, Franklin County, Ohio,

For: Nitschke, SWD.

P.B. _____ Page _____ Recorder's Office, _____ County, Ohio.
 Scale 1" = 40' Date September 28, 1988

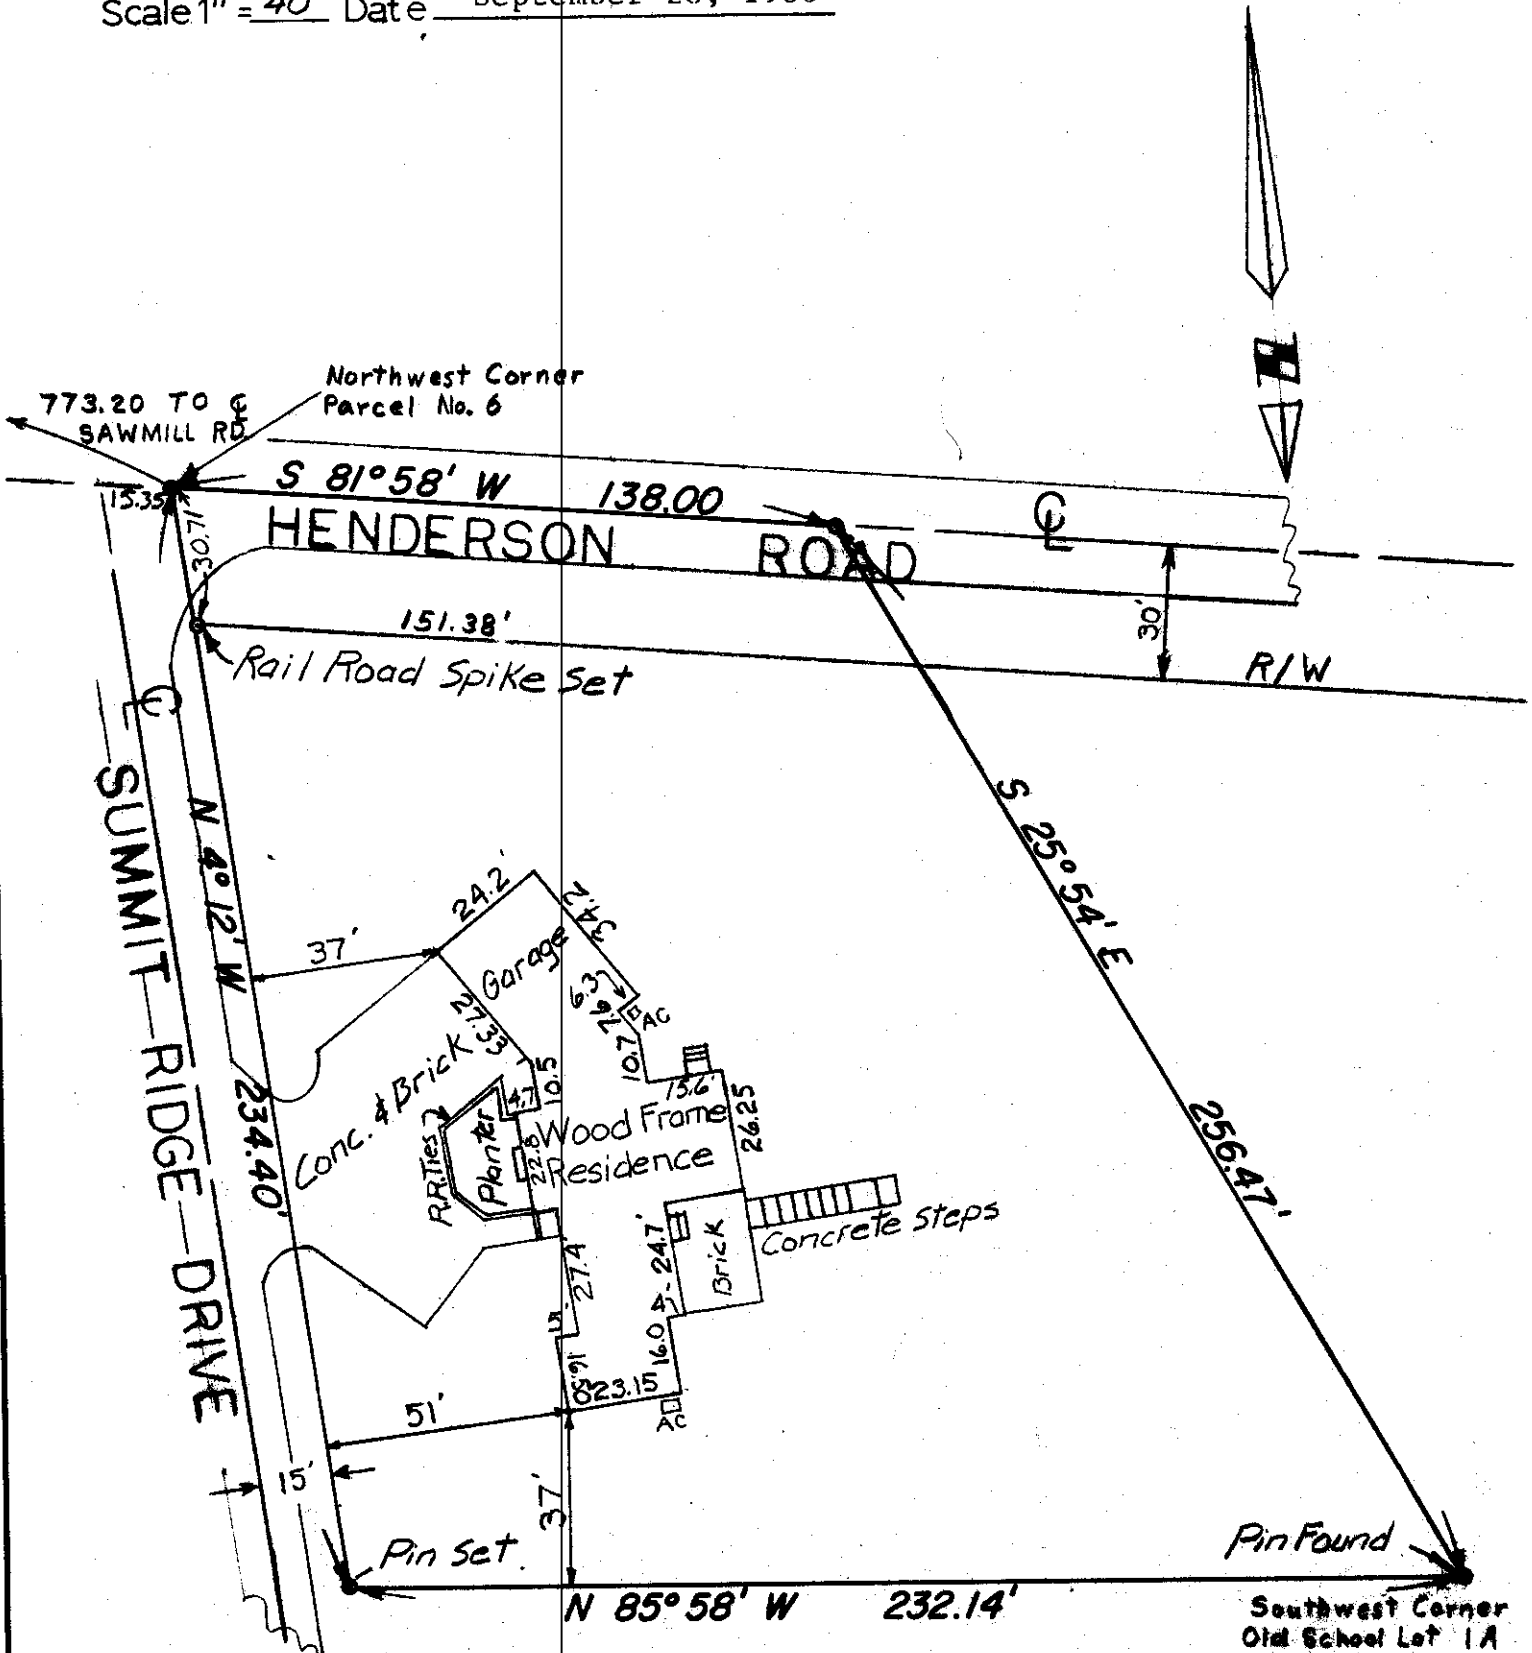

I hereby certify the above plat has been prepared from actual survey of the premises

Harry L. Greene
 Harry L. Greene, Registered Surveyor, No. 4058