PLAT SHOWING DIVISION OF LOT NO. 68, OF JOAN HEIGHTS SUBDIVISION, OF RECORD IN PLAT BOOK 18, PAGE 52, RECORDER'S OFFICE, FRANKLIN COUNTY, OHIO.

FOR

H. BURKLEY SHOWE.

Scale 1" = 20' September 23, 1980

Harry L. Greene, Reg. Surveyor, No. 4058
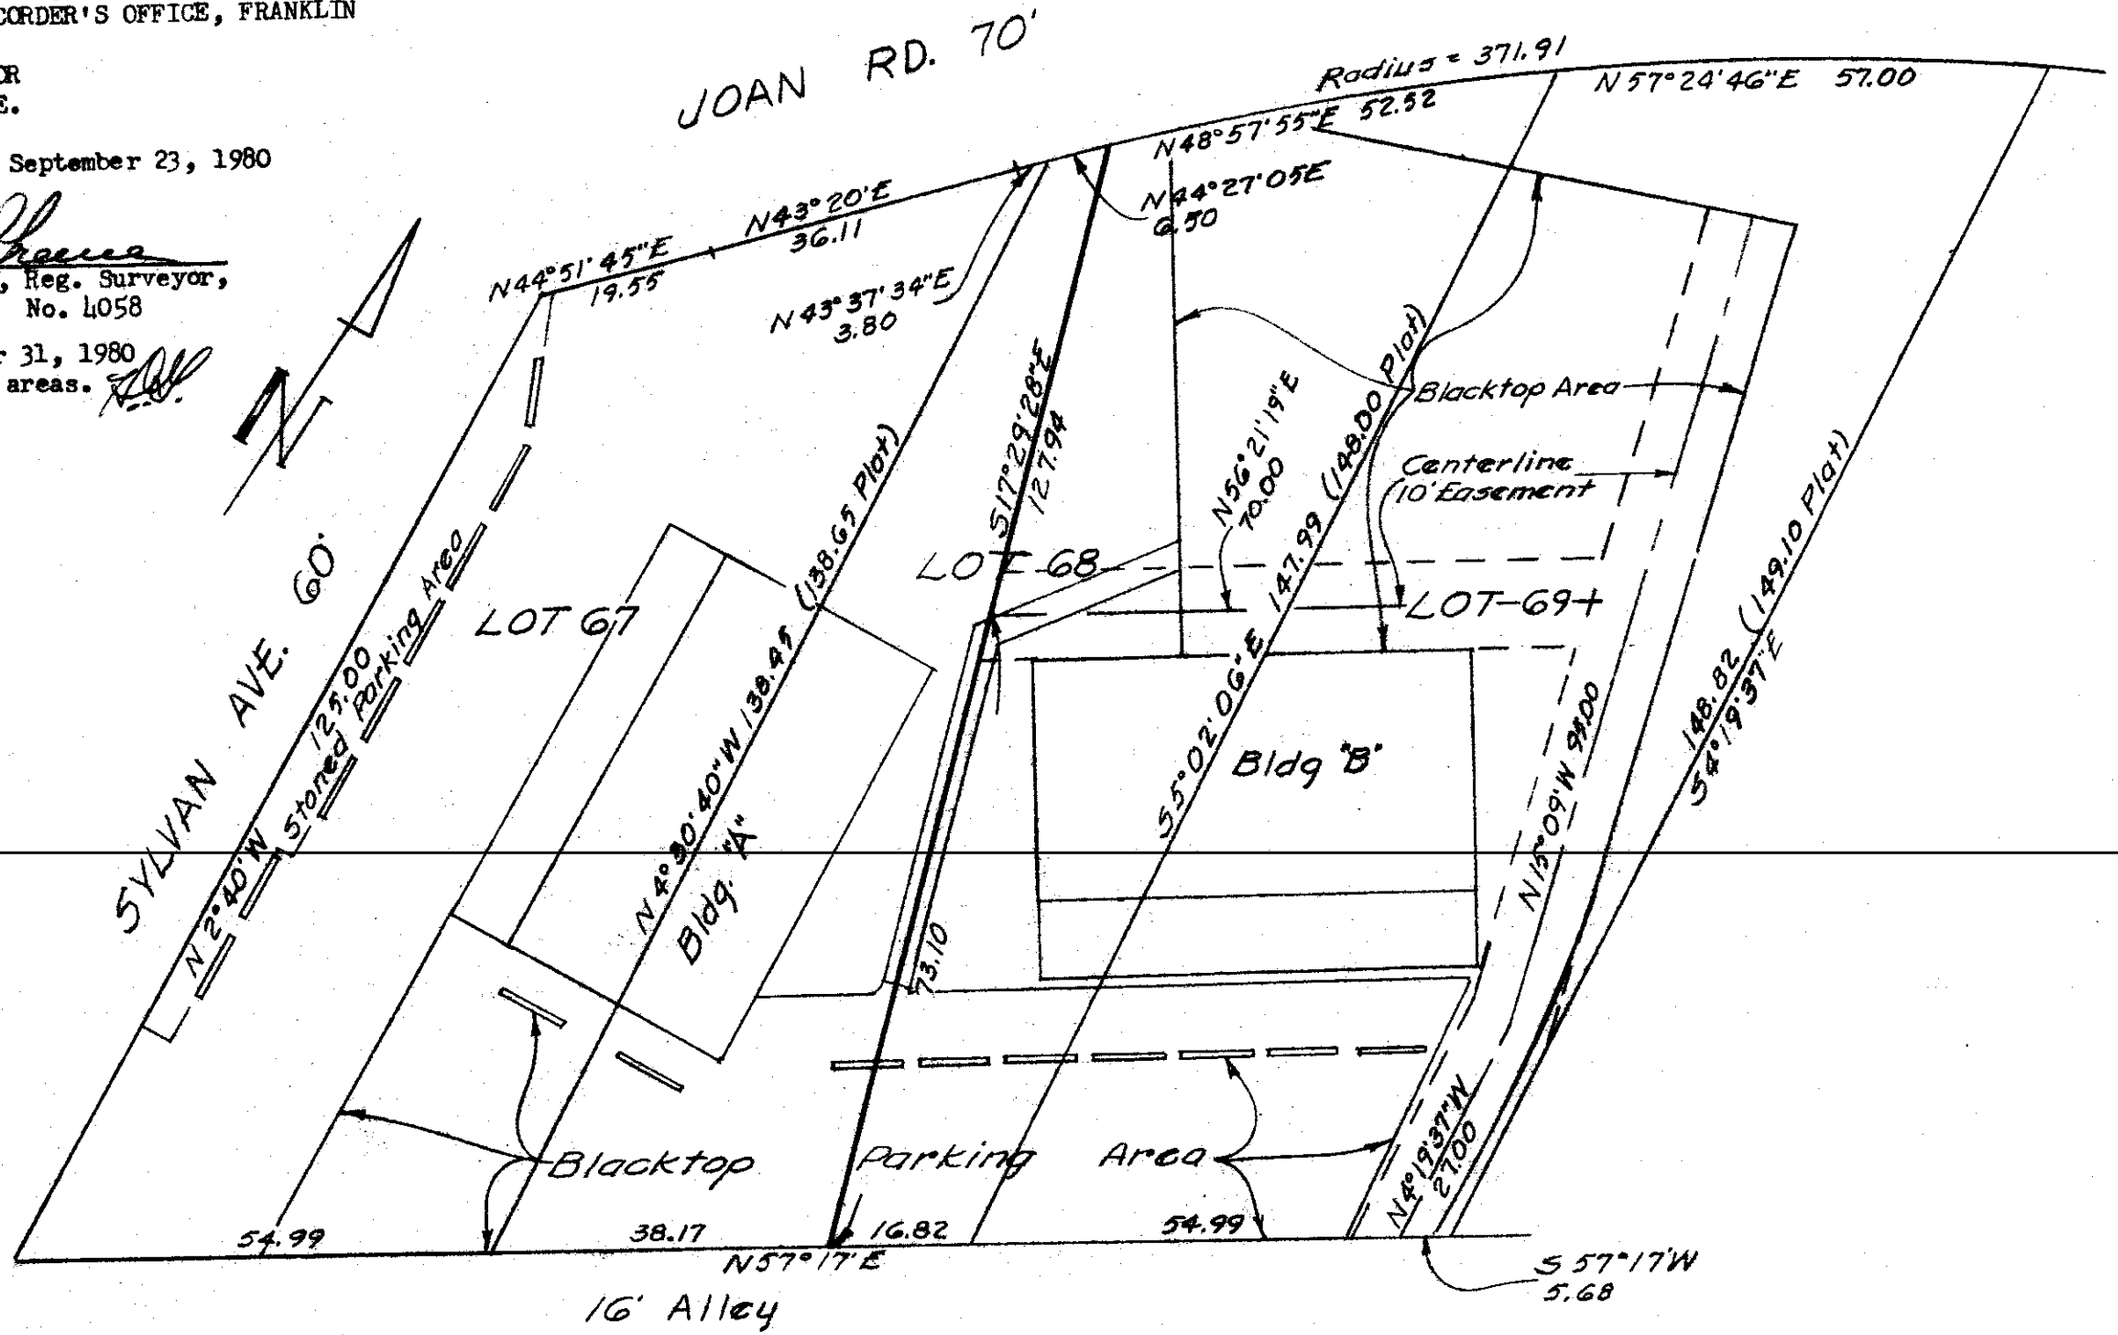
Revised December 31, 1980 to show parking areas.