Harry L. Greene, Surveyor

2160 Tremont Center, Columbus, Ohio 43221

To: Chicago Title Agency of Central Ohio, Inc.,
Sunrise Bank for Federal Savings Bank

Re: Ronald Scherer

Premises located at 5622 Riverside Drive, Dublin,

P.B. ____ Page ____ Recorders Office, Franklin County, Ohio.

Scale 1" = 100 Date April 26, 1991

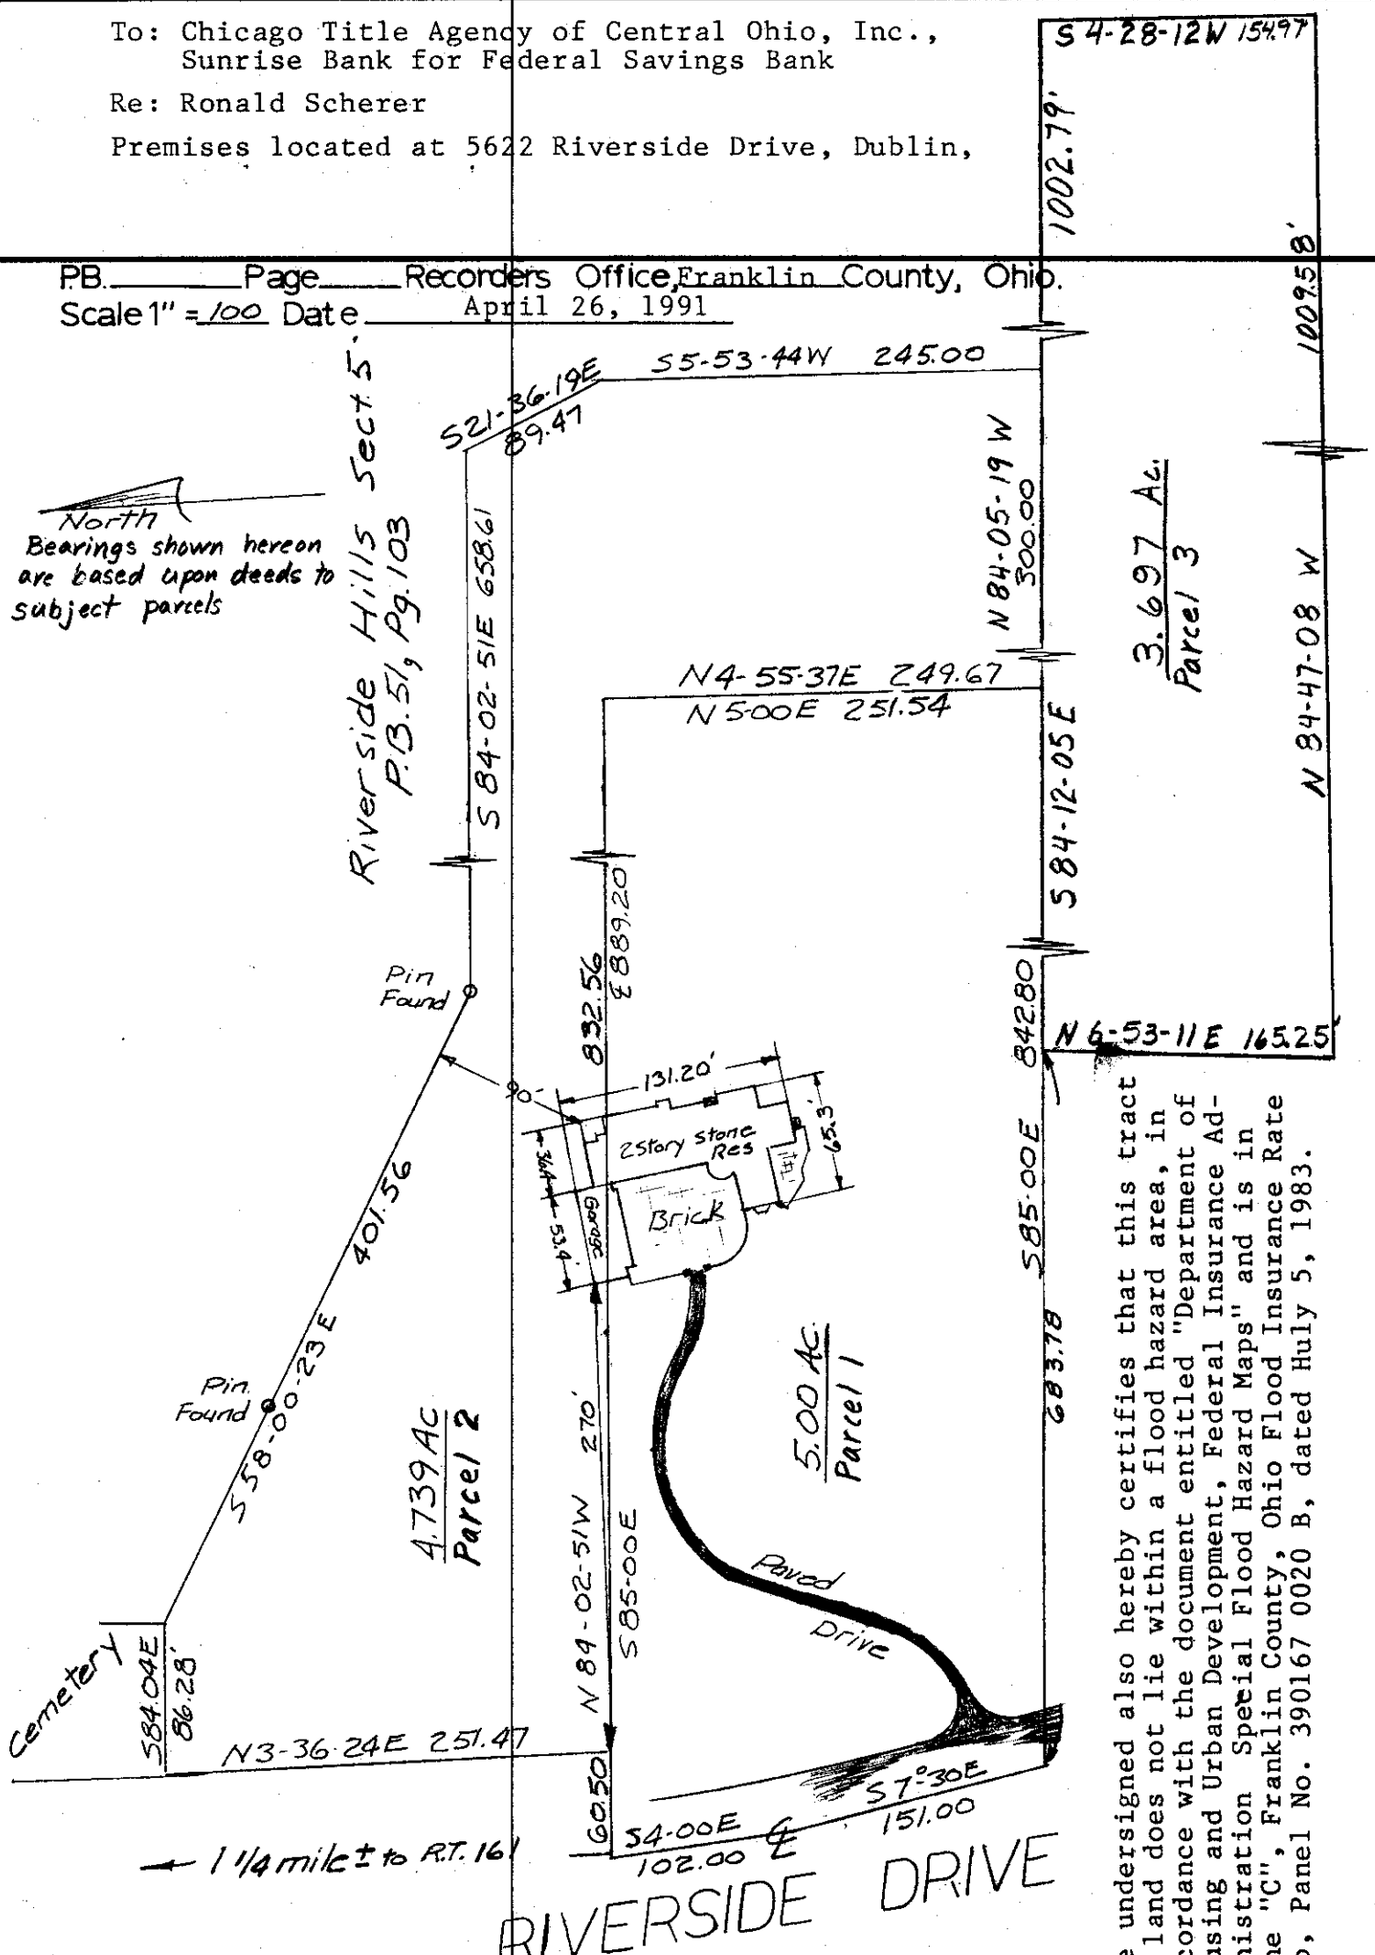

The undersigned also hereby certifies that this tract of land does not lie within a flood hazard area, in accordance with the document entitled "Department of Housing and Urban Development, Federal Insurance Administration Special Flood Hazard Maps" and is in Zone "C", Franklin County, Ohio Flood Insurance Rate Map, Panel No. 390167 0020 B, dated Huly 5, 1983.

I hereby certify the above plat has been prepared from actual survey of the premises for use in mortgage loan and title purposes only. No sideline of principal building is less than dimension shown. Property corners not located unless shown thus -o-.

Harry L. Greene

Harry L. Greene, Registered Surveyor, No. 4058