



Harry L. Greene, Surveyor

2160 Tremont Center, Columbus, Ohio 43221

To: TransOhio Title Agency Inc.,
and/or
City Loan and Savings Co.
Re: Susanne Cobey Friedman

See legal description attached hereto and hereby made a part of this survey.
(Being part of Lot No. 14 of OLD WOODS FARM SUBDIVISION NO. 2)

PB. 37 Page 7 Recorders Office, Franklin County, Ohio.
Scale 1" = 30 Date May 23, 1984

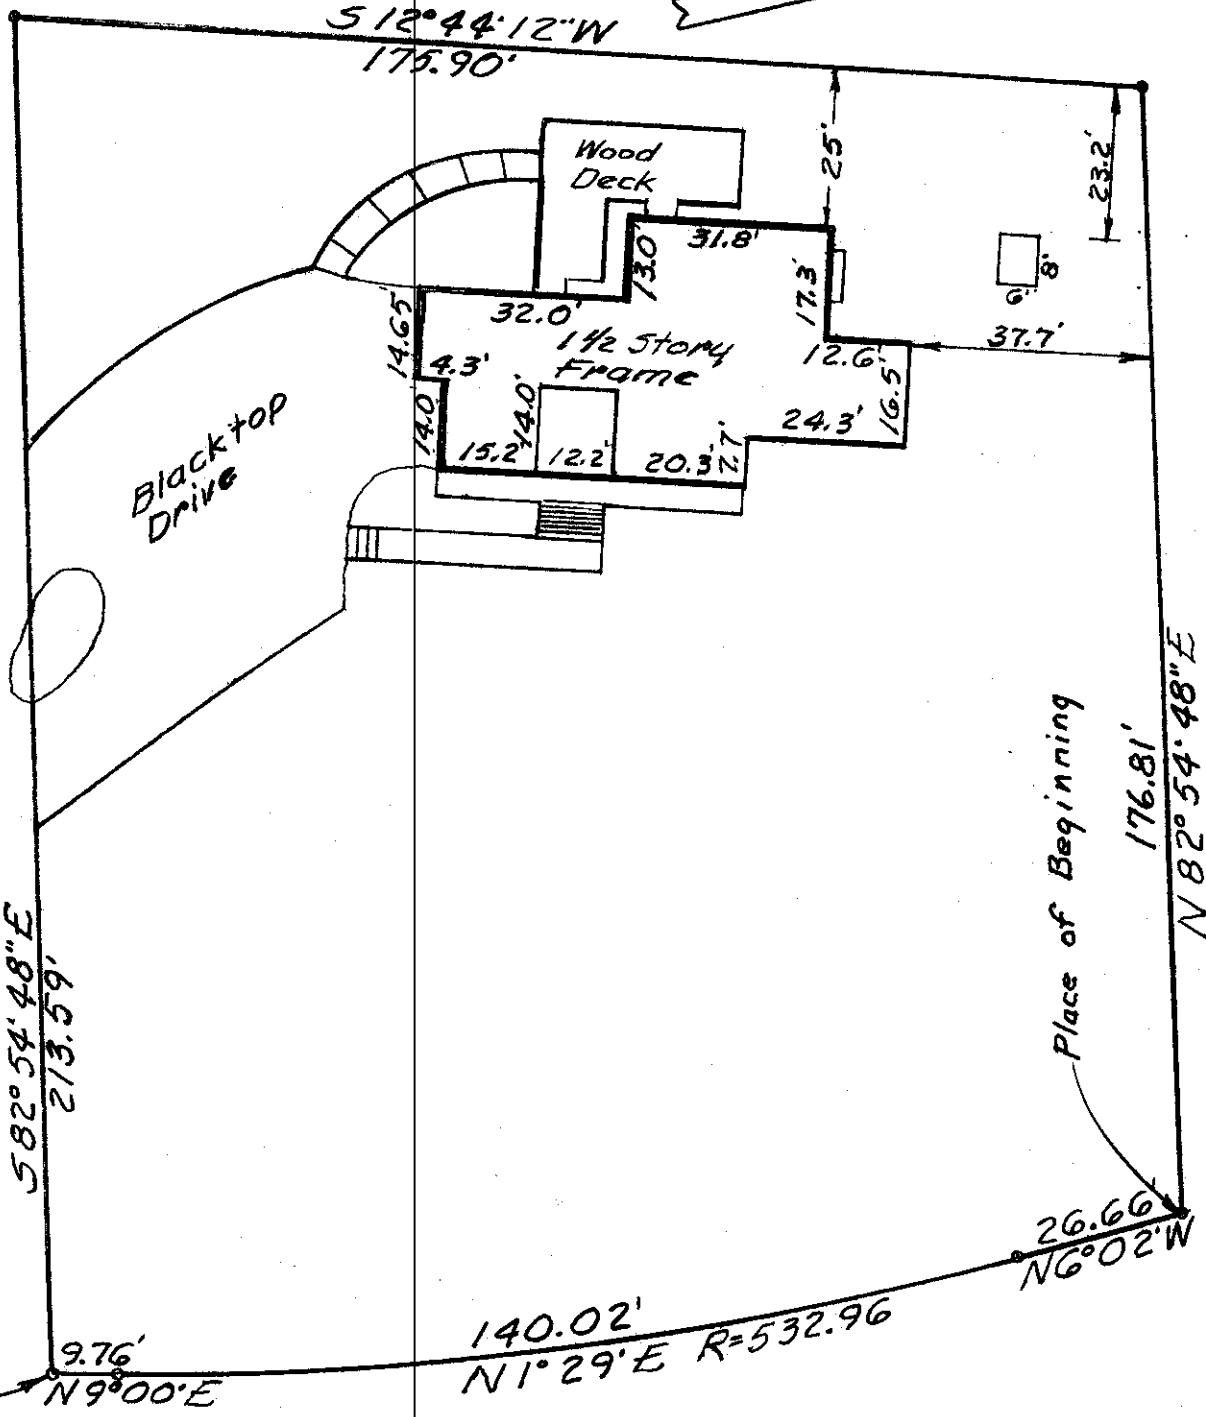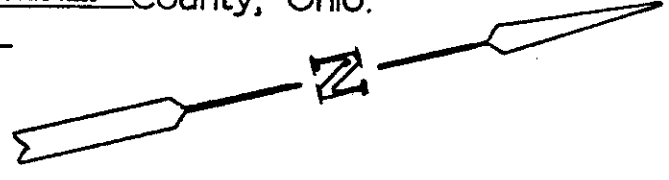

433'± to E Woods Rd

OLENTANGY RIVER ROAD



I hereby certify the above plat has been prepared from actual survey of the premises for use in mortgage loan and title purposes only. No sideline of principal building is less than dimension shown. Property corners not located unless shown thus -o-.

Harry L. Greene
Harry L. Greene, Registered Surveyor, No. 4058