Harry L. Greene, Surveyor

2160 Tremont Center, Columbus, Ohio 43221

PLAT SHOWING SURVEY OF 31.380 ACRE TRACT, BEING A PART OF VIRGINIA MILITARY SURVEY NO. 2542 AND BEING A PART OF A TRACT OF LAND AS CONVEYED TO MARTHA E. JOHNSTON AS PARCEL TWO BY DEED OF RECORD IN DEED BOOK 1993, PAGE 69 AND OFFICIAL RECORD 3888F11, RECORDER'S OFFICE, FRANKLIN COUNTY, OHIO.

P.B. _____ Page _____ Recorders Office, Franklin County, Ohio.

Scale 1" = 400' Date April 17, 1985

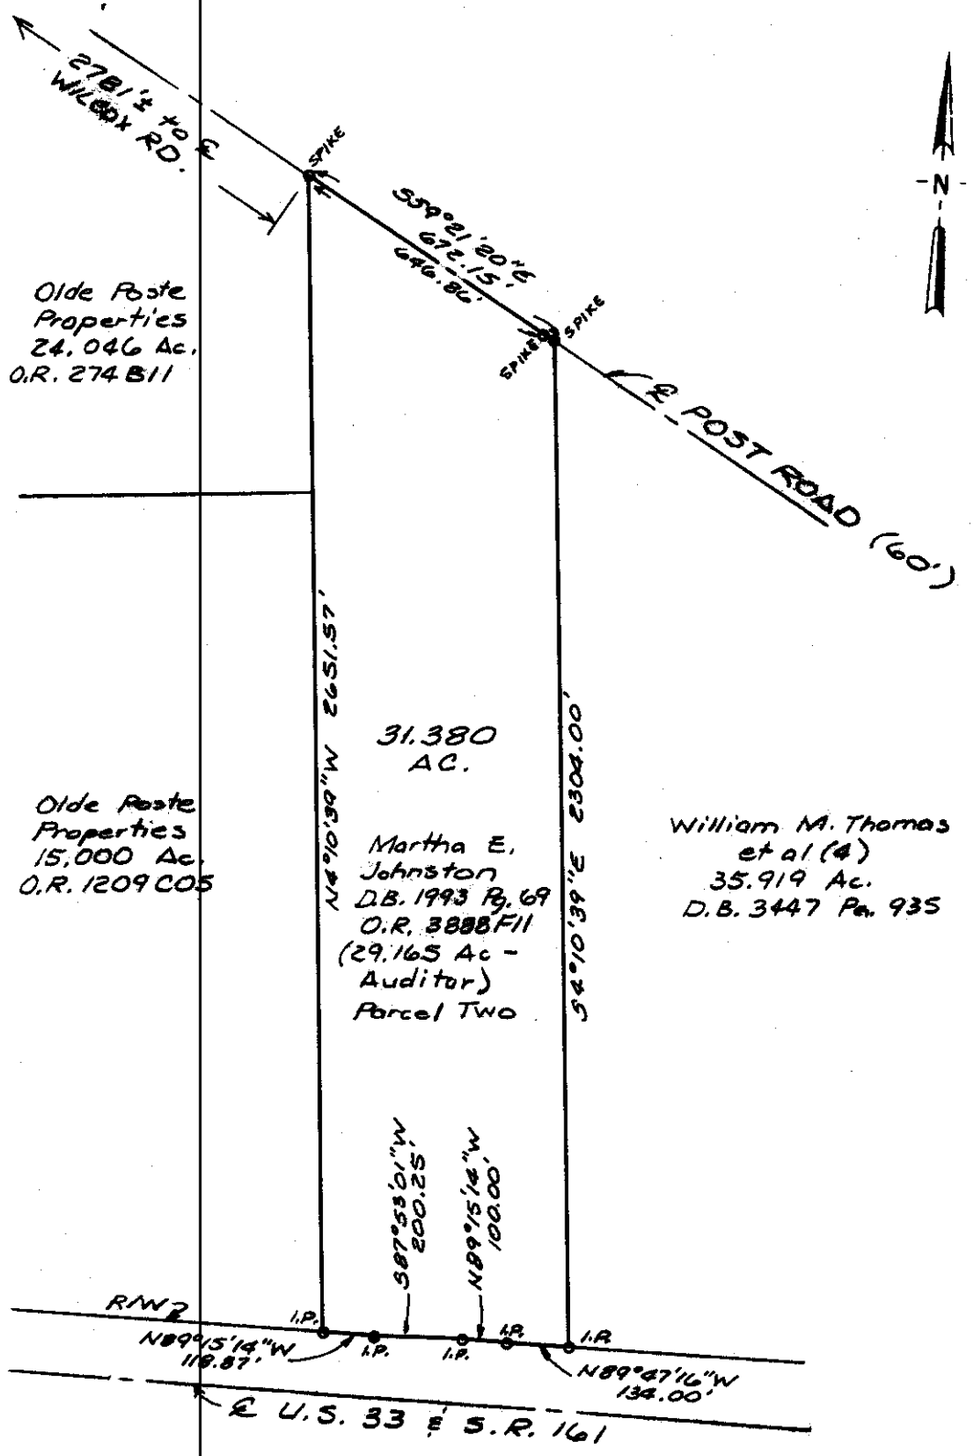

Harry L. Greene

Harry L. Greene, Registered Surveyor, No. 4058