

Harry L. Greene, Surveyor


2160 Tremont Center, Columbus, Ohio 43221

To: Title First Agency
Home Savings of America


Being Lot No. 2 of the AMENDED PLAT OF RESUBDIVISION OF LOT 72
AND PARTS OF LOTS 59, 70, AND 71, WORTHINGTON

PB. 73 Page 25 Recorders Office, Franklin County, Ohio.

Scale 1" = 20' Date August 28, 1992

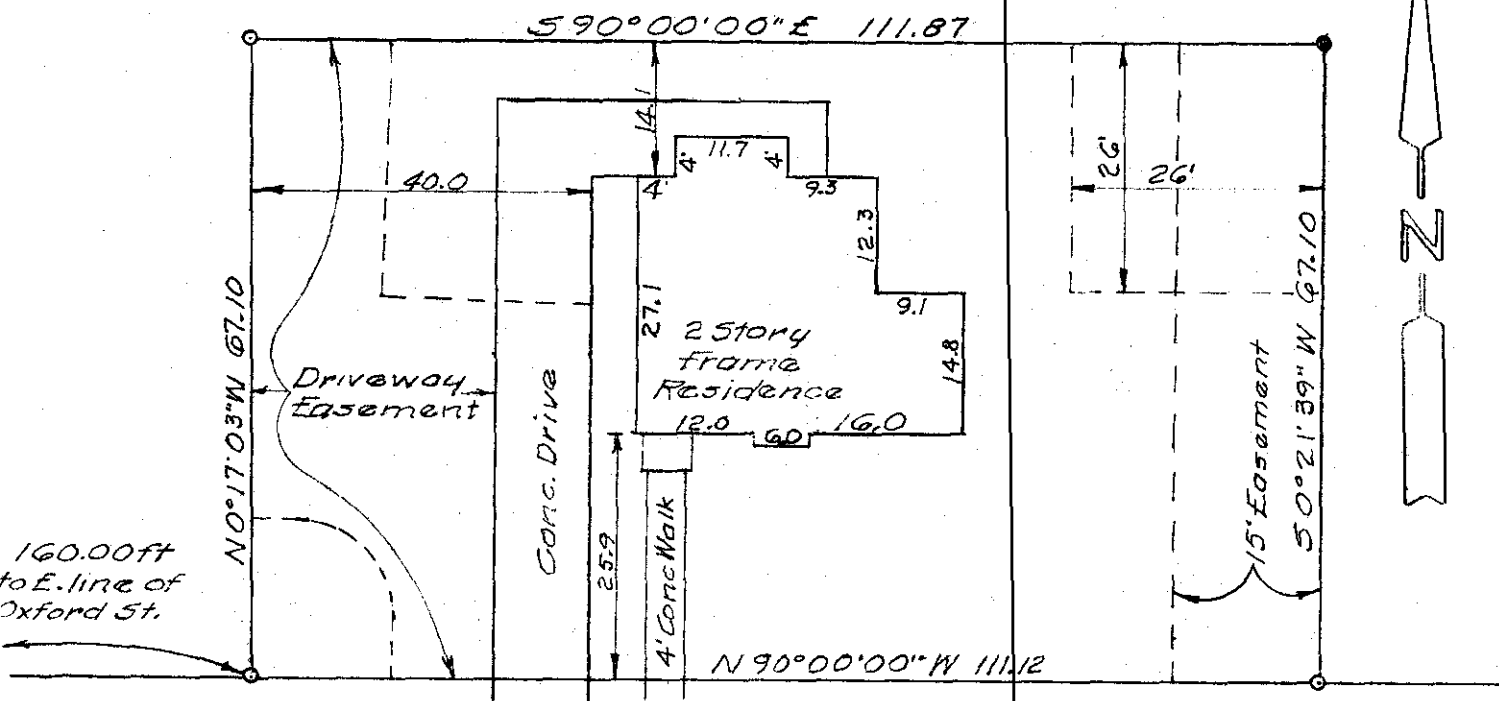

DUBLIN GRANVILLE RD S.R. 161

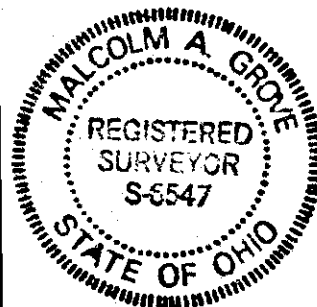

I hereby certify the above plat has been prepared from actual survey of the premises for use in mortgage loan and title purposes only. No sideline of principal building is less than dimension shown. Property corners not located unless shown thus -o-.

Malcolm A. Grove
Malcolm A. Grove Reg. Surveyor
No. S-6547