Harry L. Greene, Surveyor

2160 Tremont Center, Columbus, Ohio 43221

To: Huntington Mortgage Company
Re: Rice-Kelsik Development
Situated in the State of Ohio, County of Franklin, and Village of Dublin
Being Lot Number Eleven (11) in Subdivision of Lot No. 2, of Waterford Village, Phase 3, as the same is numbered and delineated upon the recorded plat thereof of record in Plat Book 53, Page 14, Recorder's Office, Franklin County, Ohio.

P.B. 53 Page 14 Recorder's Office, Franklin County, Ohio.
Scale 1" = 20 Date June 20, [redacted]
Rev. July 13, 1983 - to show bldg. foundation.

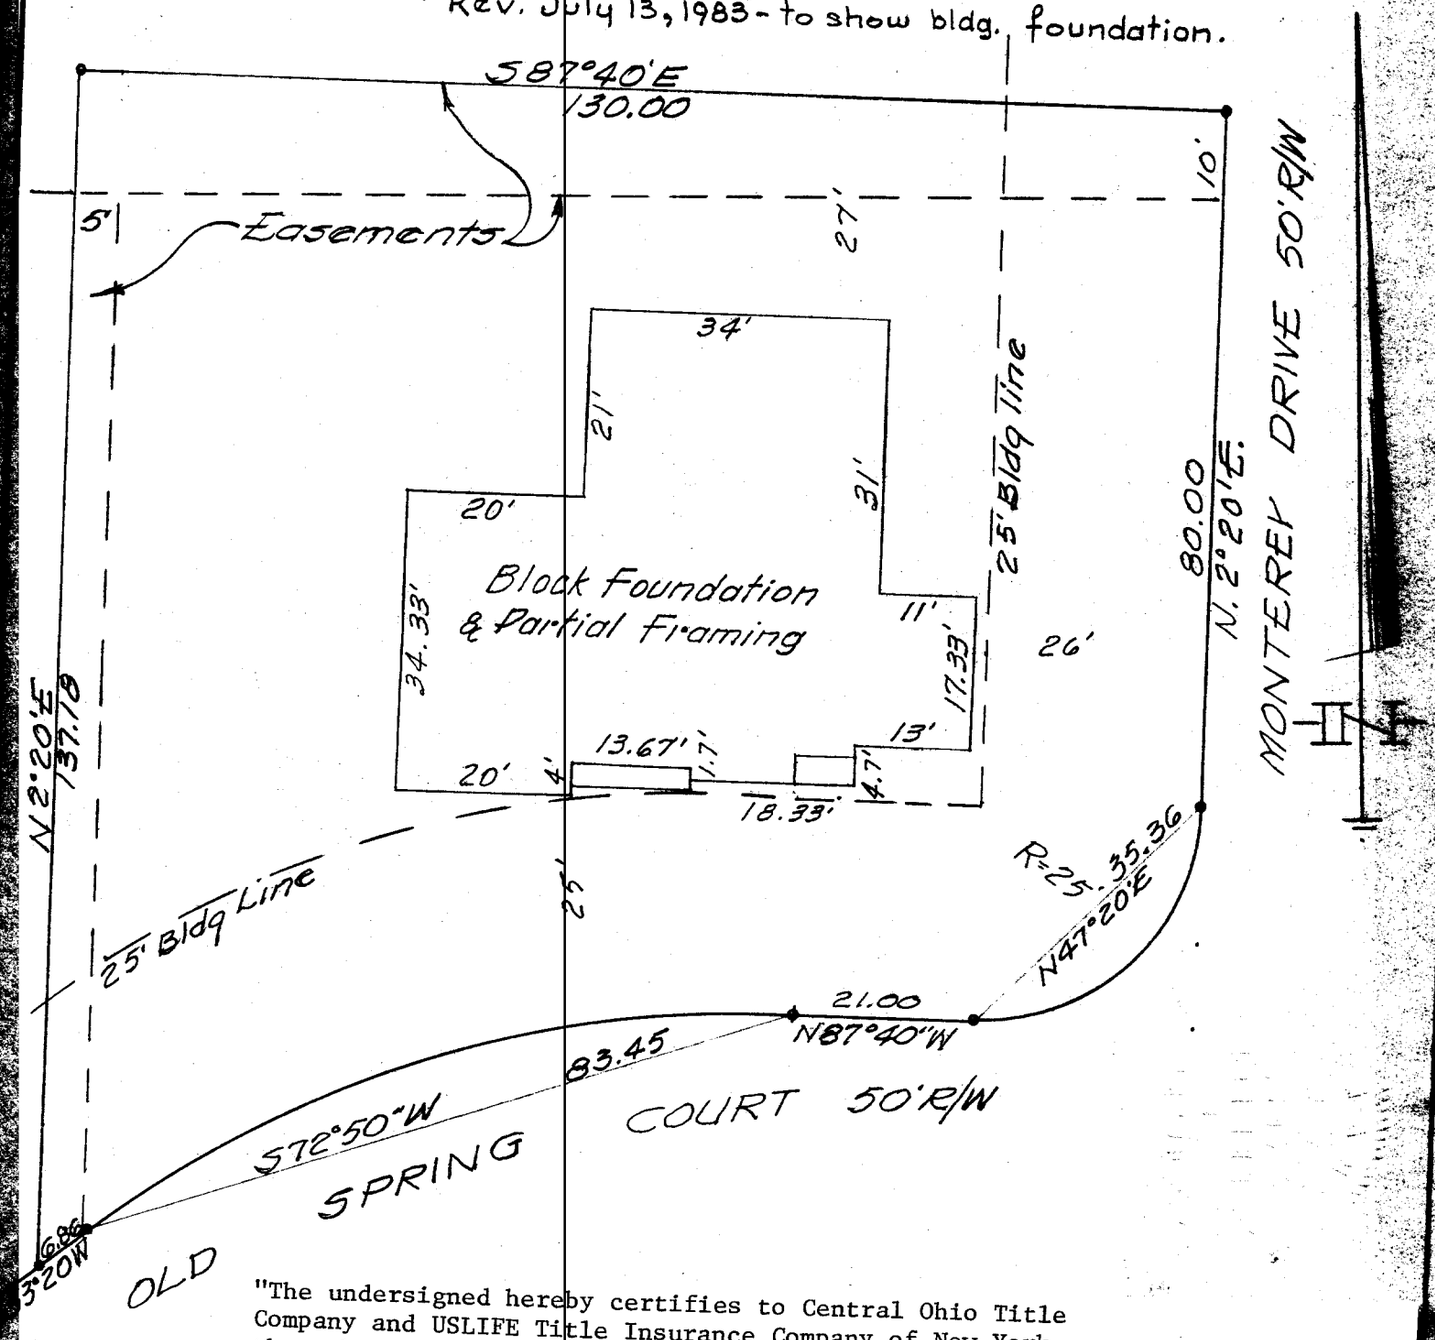

"The undersigned hereby certifies to Central Ohio Title Company and USLIFE Title Insurance Company of New York that the attached survey correctly shows the location of all buildings, structures and other improvements situated on the premises; and that except as shown, there are no visible easements or rights-of-way across said premises or any other easements or rights-of-way of which the undersigned has been advised, no party walls, no encroachments on adjoining premises, streets or alleys by any of said buildings, structures or other improvements, and no encroachments on said premises by buildings, structures or other improvements, situated on adjoining premises."

I hereby certify the above plat has been prepared from actual survey of the premises for use in mortgage loan and title purposes only. No sidelines of principal building is less than dimension shown. Property corners not located unless shown thus -o-.

Harry L. Greene, Registered Surveyor, No. 4026