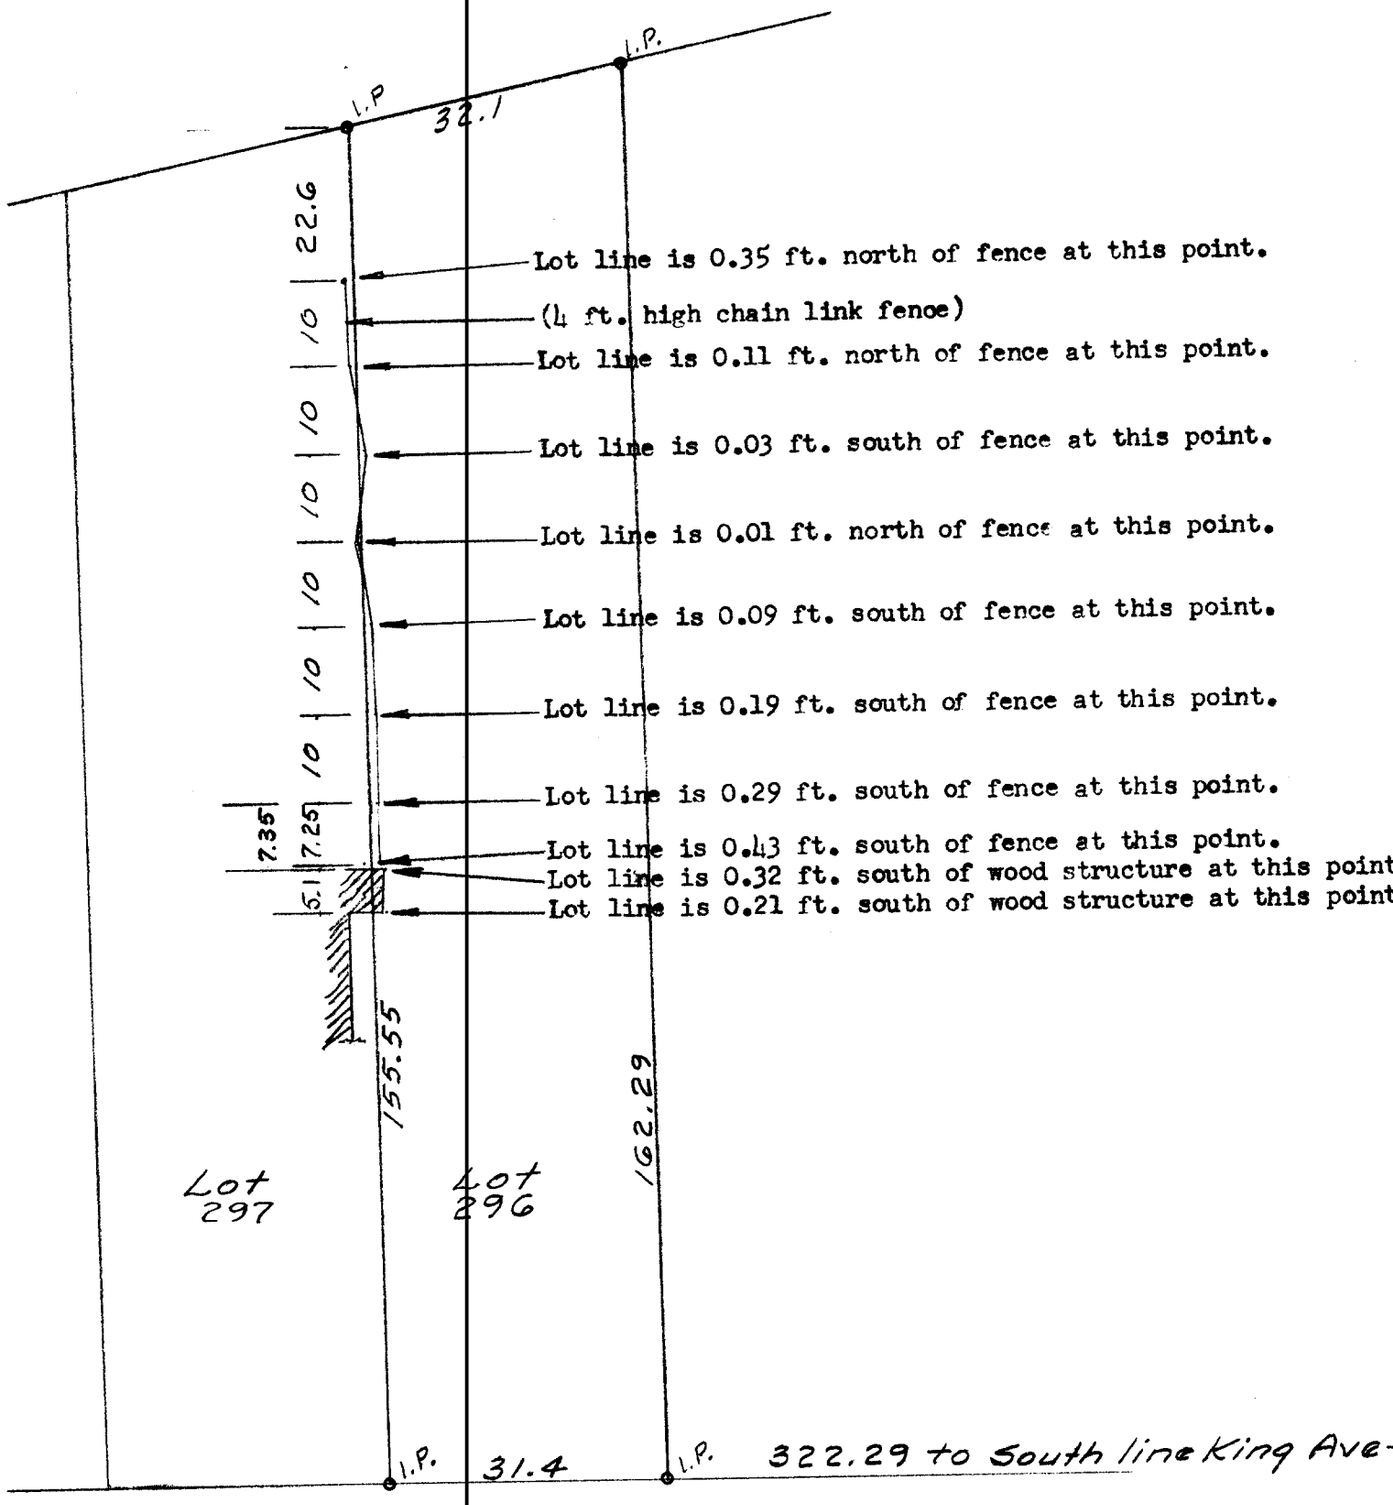

FORSYTHE AVE.

Oct 1977
Scale 1" = 20'

PLAT SHOWING SURVEY OF LOT NO. 296, DENNISON PLACE ADDITION, OF RECORD IN PLAT BOOK 3, PAGES 13 AND 14, RECORDER'S OFFICE, FRANKLIN COUNTY, OHIO.

Harry L. Greene

Harry L. Greene, Reg. Surveyor, No. 4058.