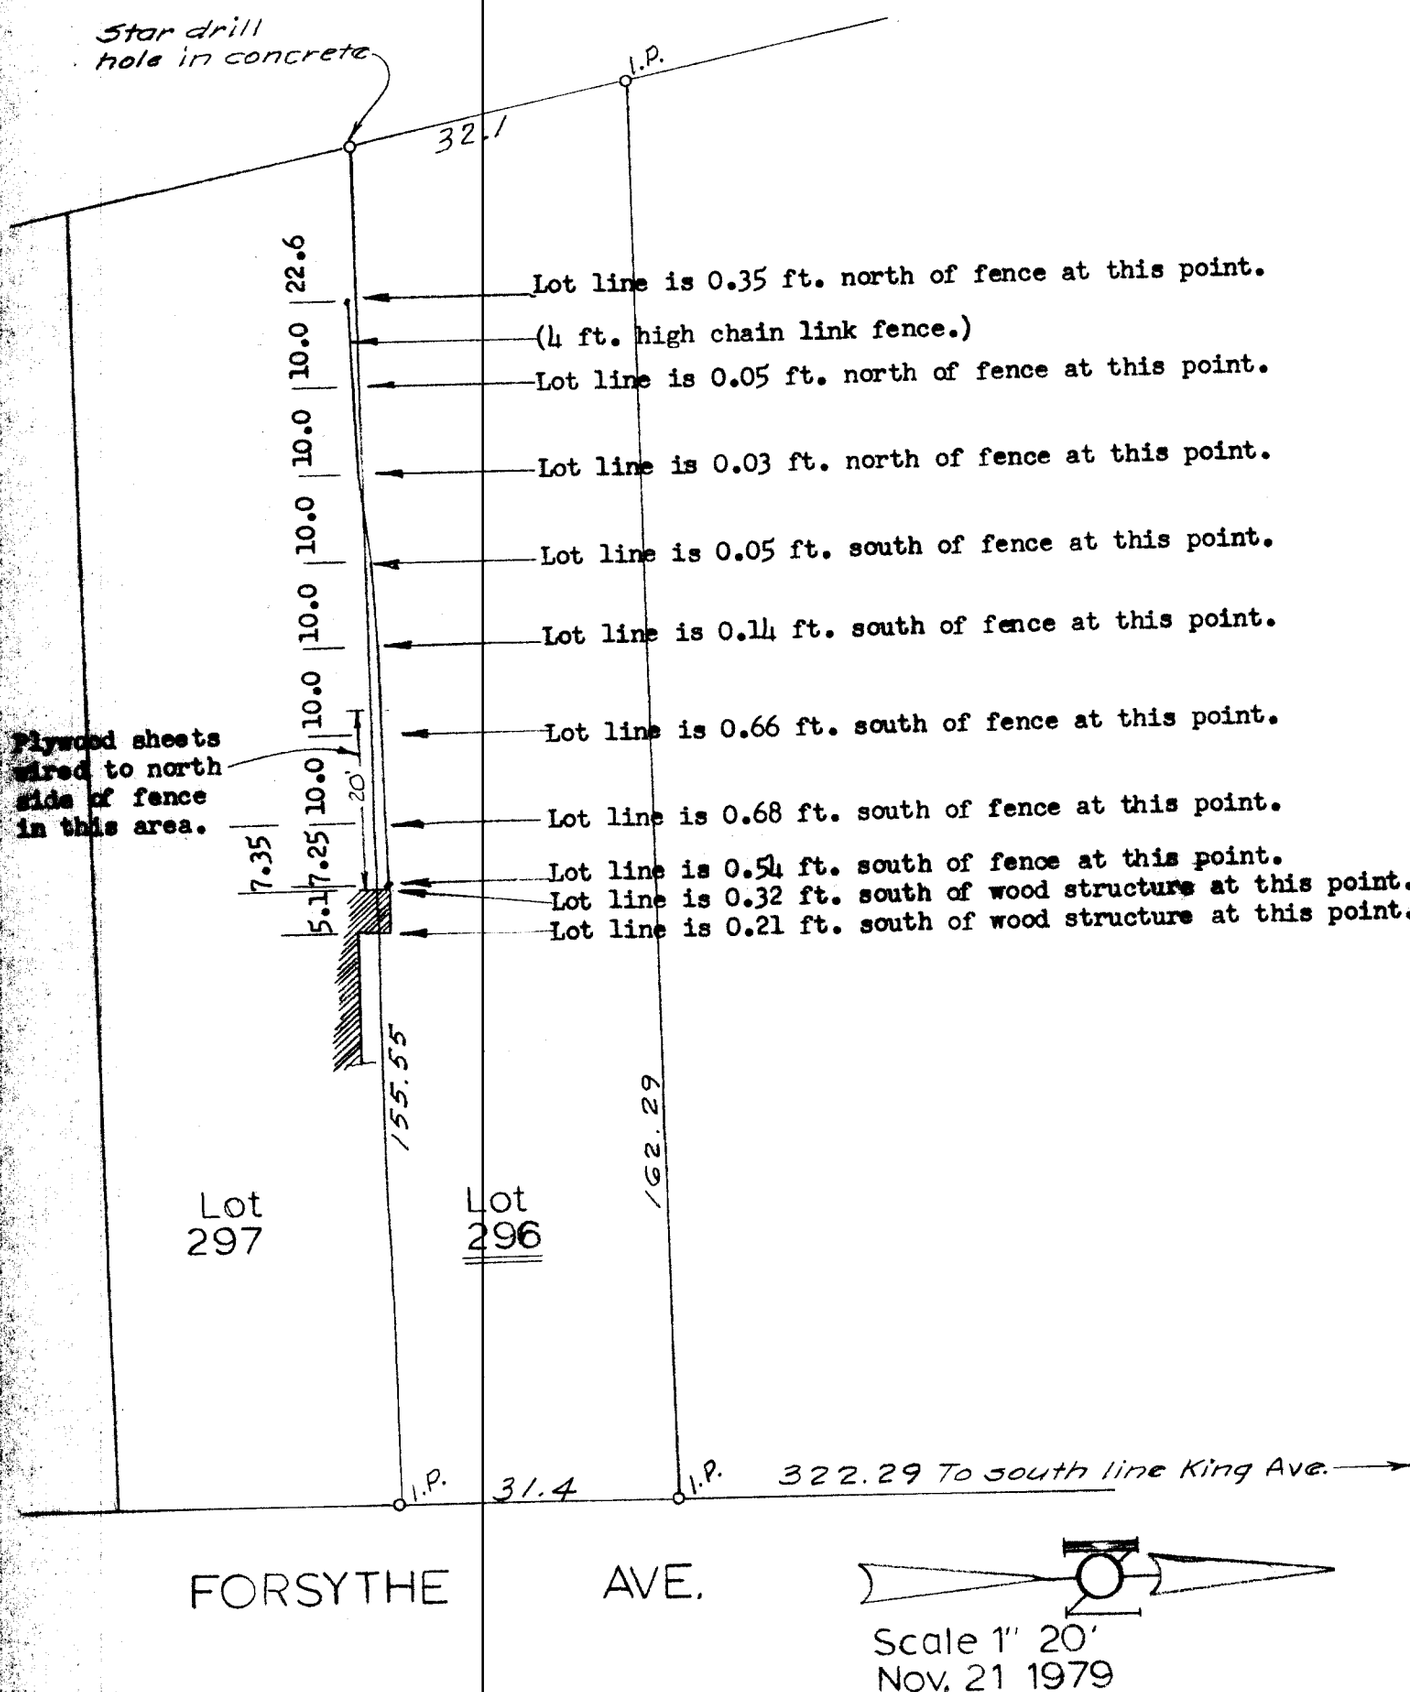

PLAT SHOWING SURVEY OF LOT NO. 296, DENNISON PLACE ADDITION, OF RECORD IN PLAT BOOK 3, PAGES 13 and 14, RECORDER'S OFFICE, FRANKLIN, COUNTY, OHIO.

Harry L. Greene

Harry L. Greene, Reg. Surveyor, No. 4058