Harry L. Greene, Surveyor

2160 Tremont Center, Columbus, Ohio 43221

PLAT SHOWING AS BUILT SURVEY OF 1.394 ACRE TRACT, 5176 FISHER ROAD, CITY OF COLUMBUS, OHIO.

P.B. _____ Page _____ Recorders Office, Franklin County, Ohio.
Scale 1" = 50' Date October 18, 1989

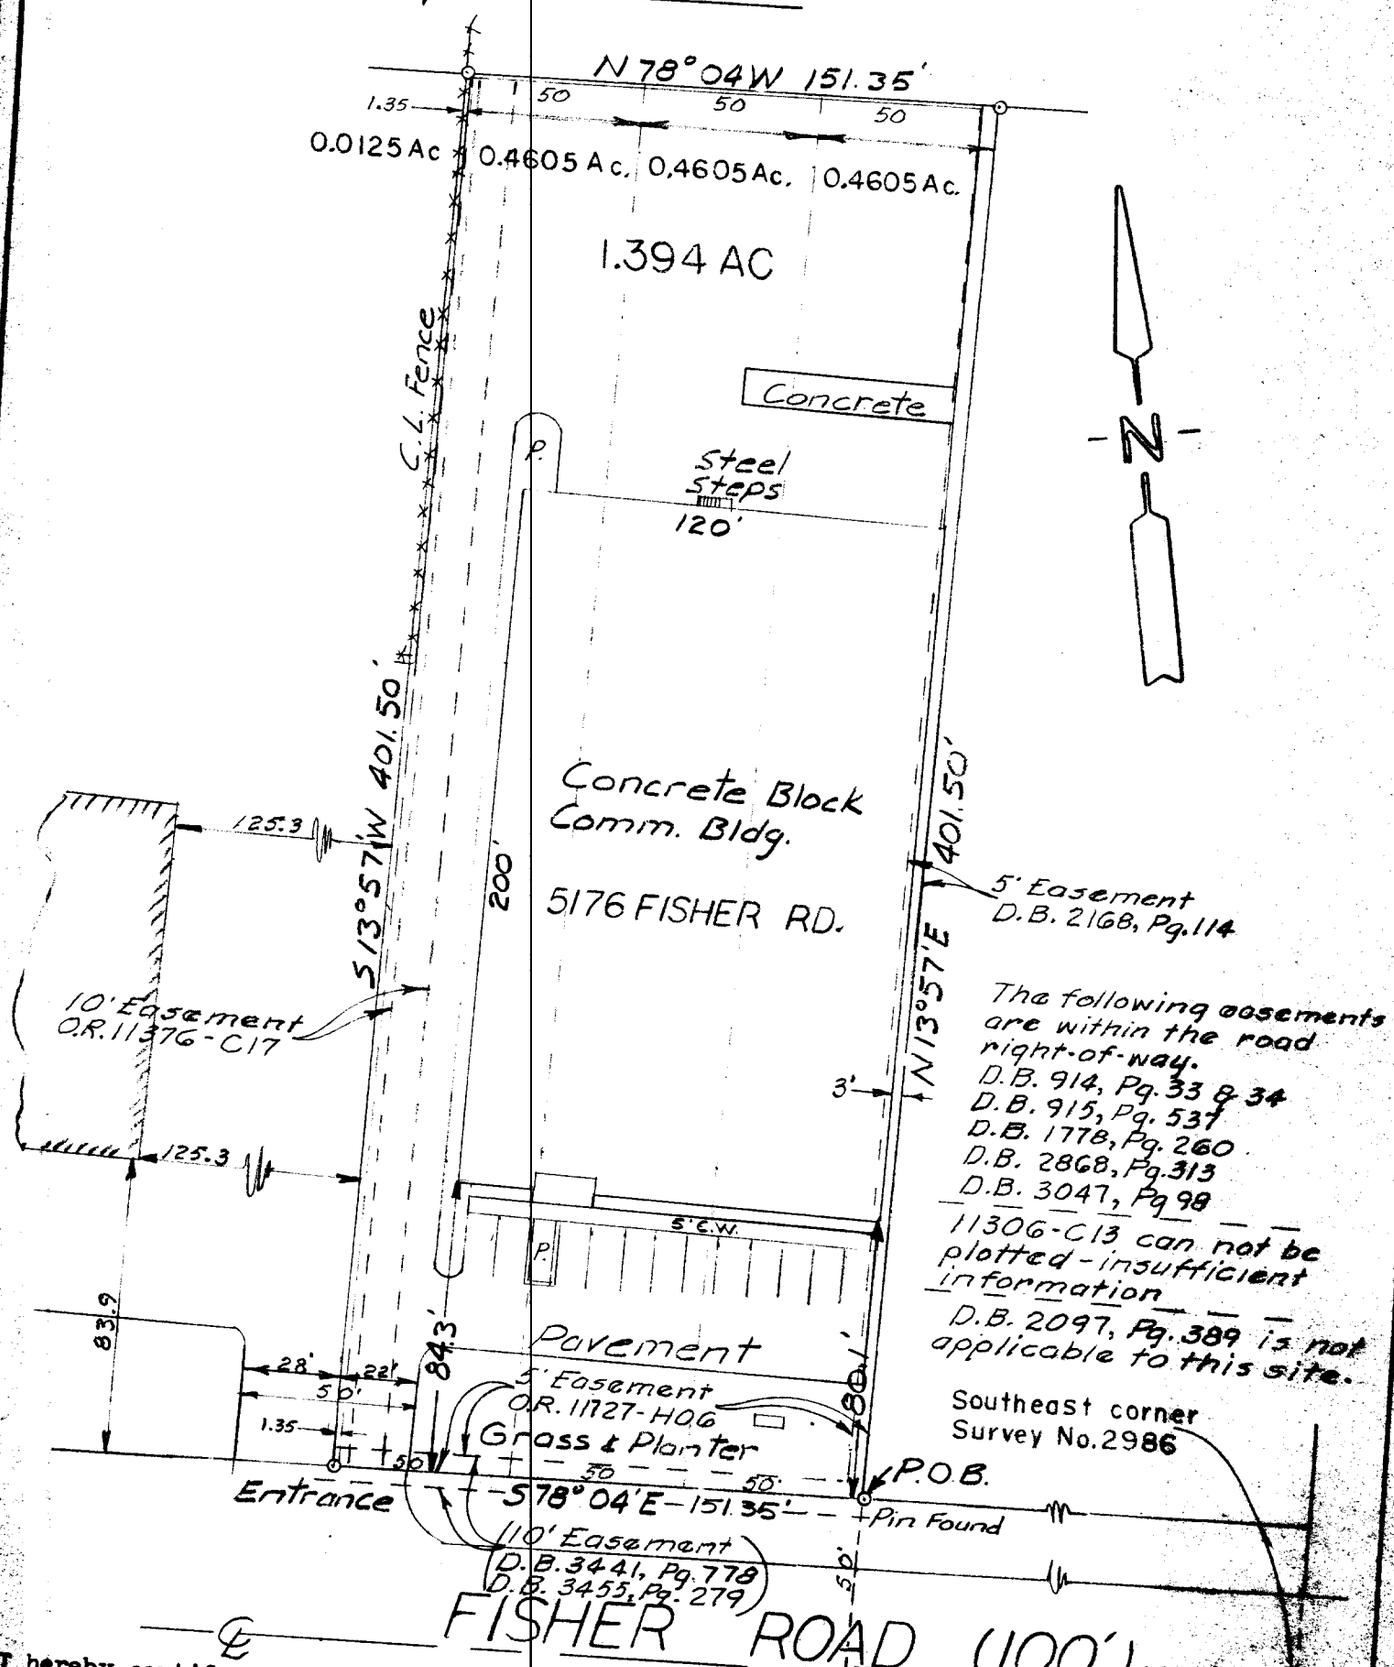

The following easements are within the road right-of-way.
D.B. 914, Pg. 33 & 34
D.B. 915, Pg. 537
D.B. 1778, Pg. 260
D.B. 2868, Pg. 313
D.B. 3047, Pg. 98
11306-C13 can not be plotted - insufficient information
D.B. 2097, Pg. 389 is not applicable to this site.

I hereby certify the above plat has been prepared from actual survey of the premises for use in mortgage loan and title purposes only. No sideline of principal building is less than dimension shown. Property corners not located unless shown thus -o-.

NOTE: Bearings shown hereon were taken from deed to subject property.

Harry L. Greene

Harry L. Greene, Registered Surveyor, No. 6057