# Harry L. Greene, Surveyor

2160 Tremont Center, Columbus, Ohio 43221

For: Chicago Title Agency of Central Ohio, Inc.
Huntington Mortgage Company

Being Lot No. 38, LANE ACRES, City of Upper Arlington, Ohio
4410 Clearbrook Court, Columbus, Ohio

P.B. 36 Page 56-57 Recorders Office, Franklin County, Ohio.
Scale 1" = 20' Date May 1, 1980
Revised June 10, 1991

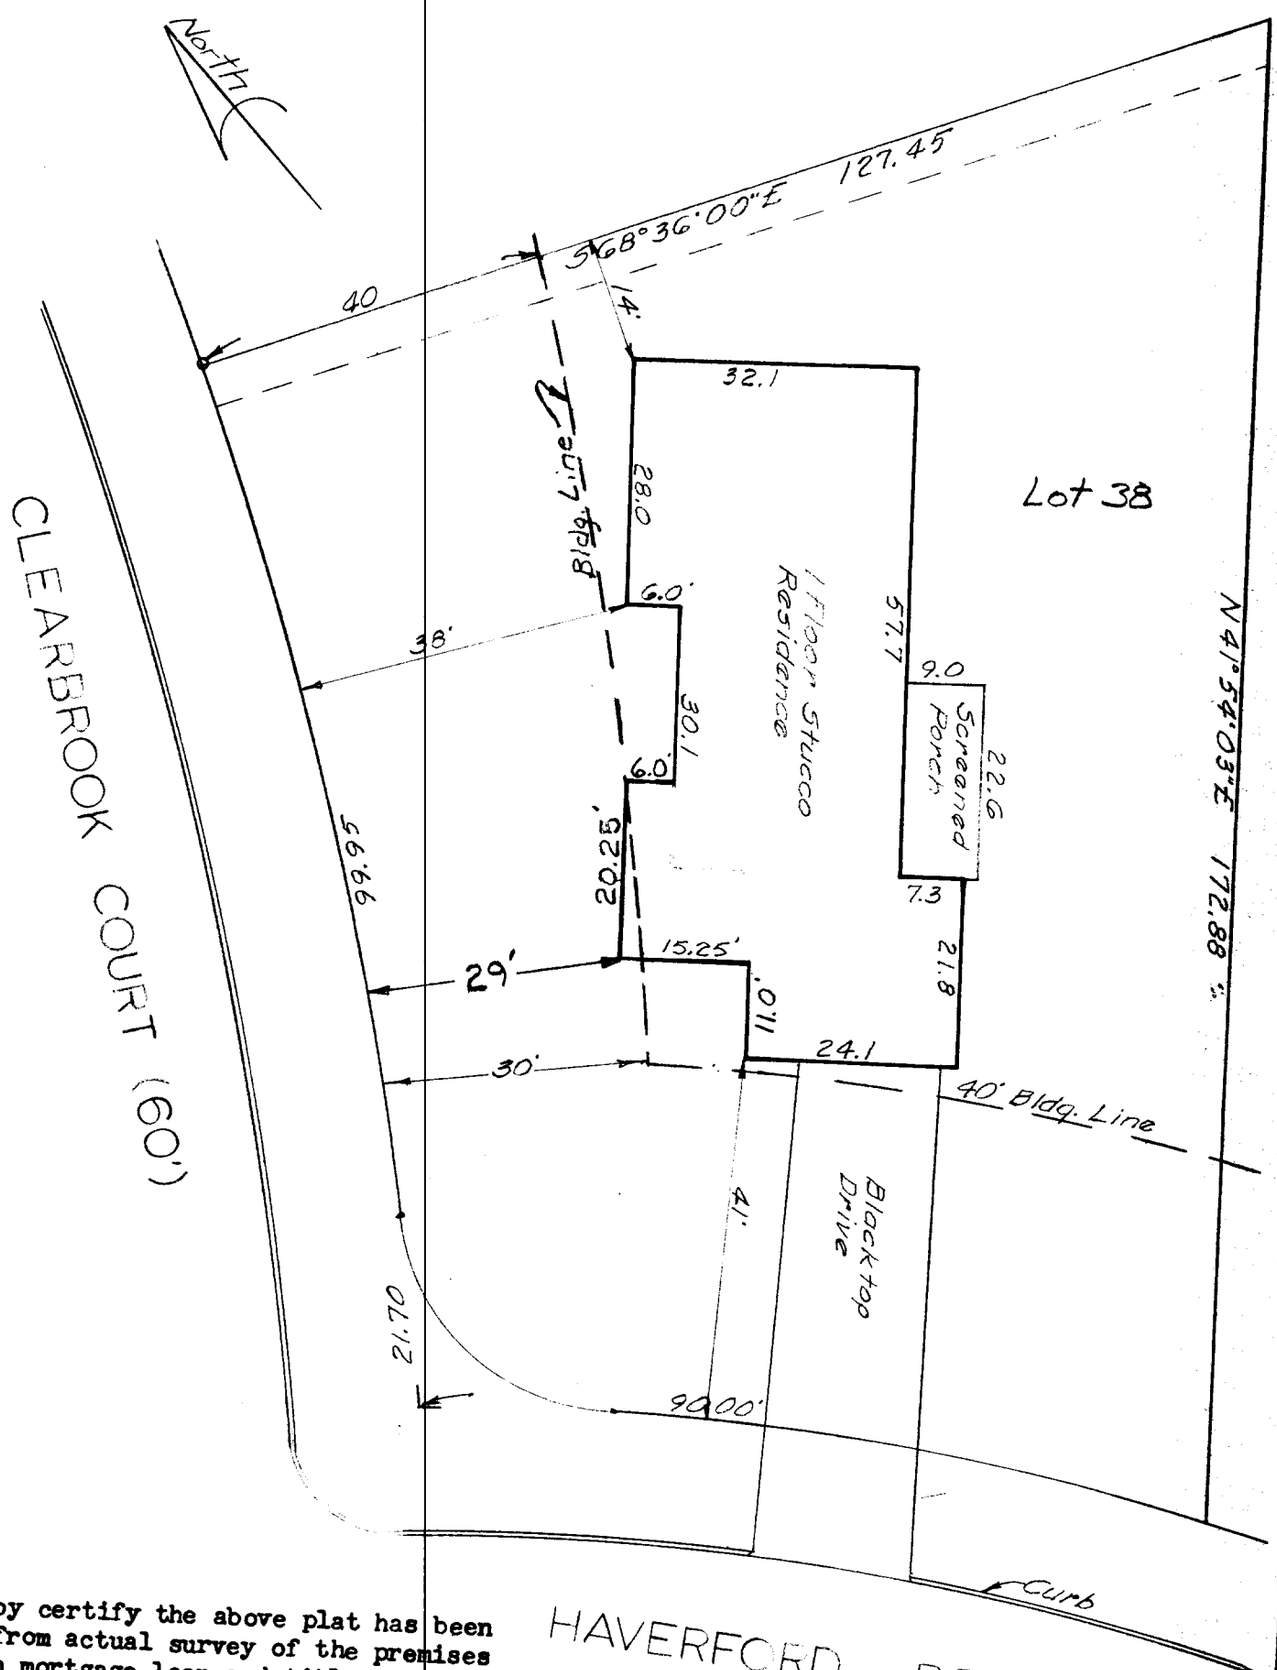


I hereby certify the above plat has been prepared from actual survey of the premises for use in mortgage loan and title purposes only. No sideline of principal building is less than dimension shown. Property corners not located unless shown thus -o-.

Harry L. Greene

Harry L. Greene, Registered Surveyor, No. 4058