Harry L. Greene, Surveyor

2160 Tremont Center, Columbus, Ohio 43221

FAS LUBE
2172 E. DUBLIN GRANVILLE ROAD
CITY OF COLUMBUS, OHIO

SEE ATTACHED EXHIBIT "A" FOR LEGAL DESCRIPTION AND CERTIFICATION
SEE ALSO ATTACHED EXHIBIT "B"

P.B. 20 Page 1 Recorders Office, Franklin County, Ohio.
Scale 1" = 30' Date August 2, 1989

EASEMENTS THAT DO NOT AFFECT THIS TRACT.

DEED BOOK 3251, PAGE 602
DEED BOOK 897, PAGE 266
DEED BOOK 3018, PAGE 251

I hereby certify to Society Bank and American Realty Title Assurance Company, that the legal descriptions comprising each of these properties are adjacent and continuous and no gaps or gores exist between any of the described parcels.

Harry L. Greene, Reg. Surveyor No. 4058

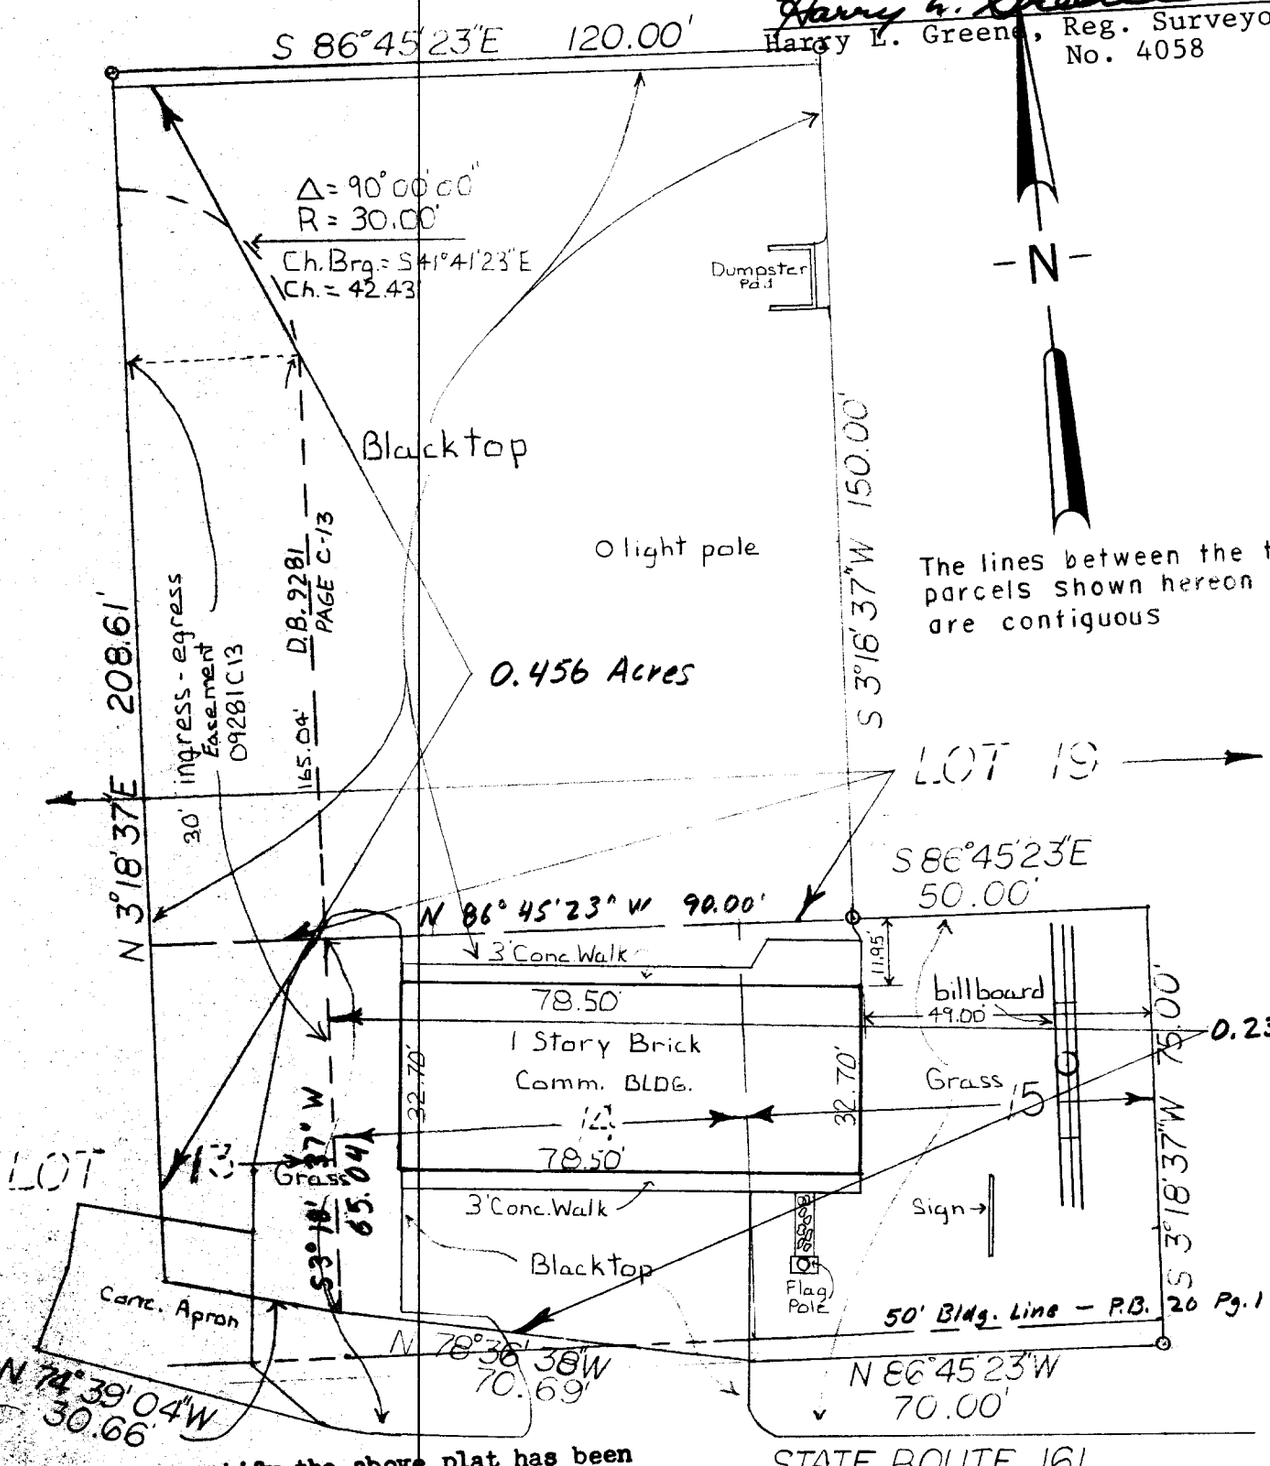

I hereby certify the above plat has been prepared from actual survey of the premises for use in mortgage loan and title purposes only. No sideline of principal building is less than dimension shown. Property corners not located unless shown thus -o-.

Harry L. Greene, Registered Surveyor, No. 4