


Harry L. Greene, Surveyor

2160 Tremont Center, Columbus, Ohio 43221

Plat showing Survey of split of Lot No. 7 of The Nellans Subdivision, Vacated Rita Drive and a One (1) Foot Reserve. City of Upper Arlington, Franklin County, Ohio.

PB. 21 Page 19 Recorders Office, FRANKLIN County, Ohio.

Scale 1" = 60' Date SEPT. 18, 1985

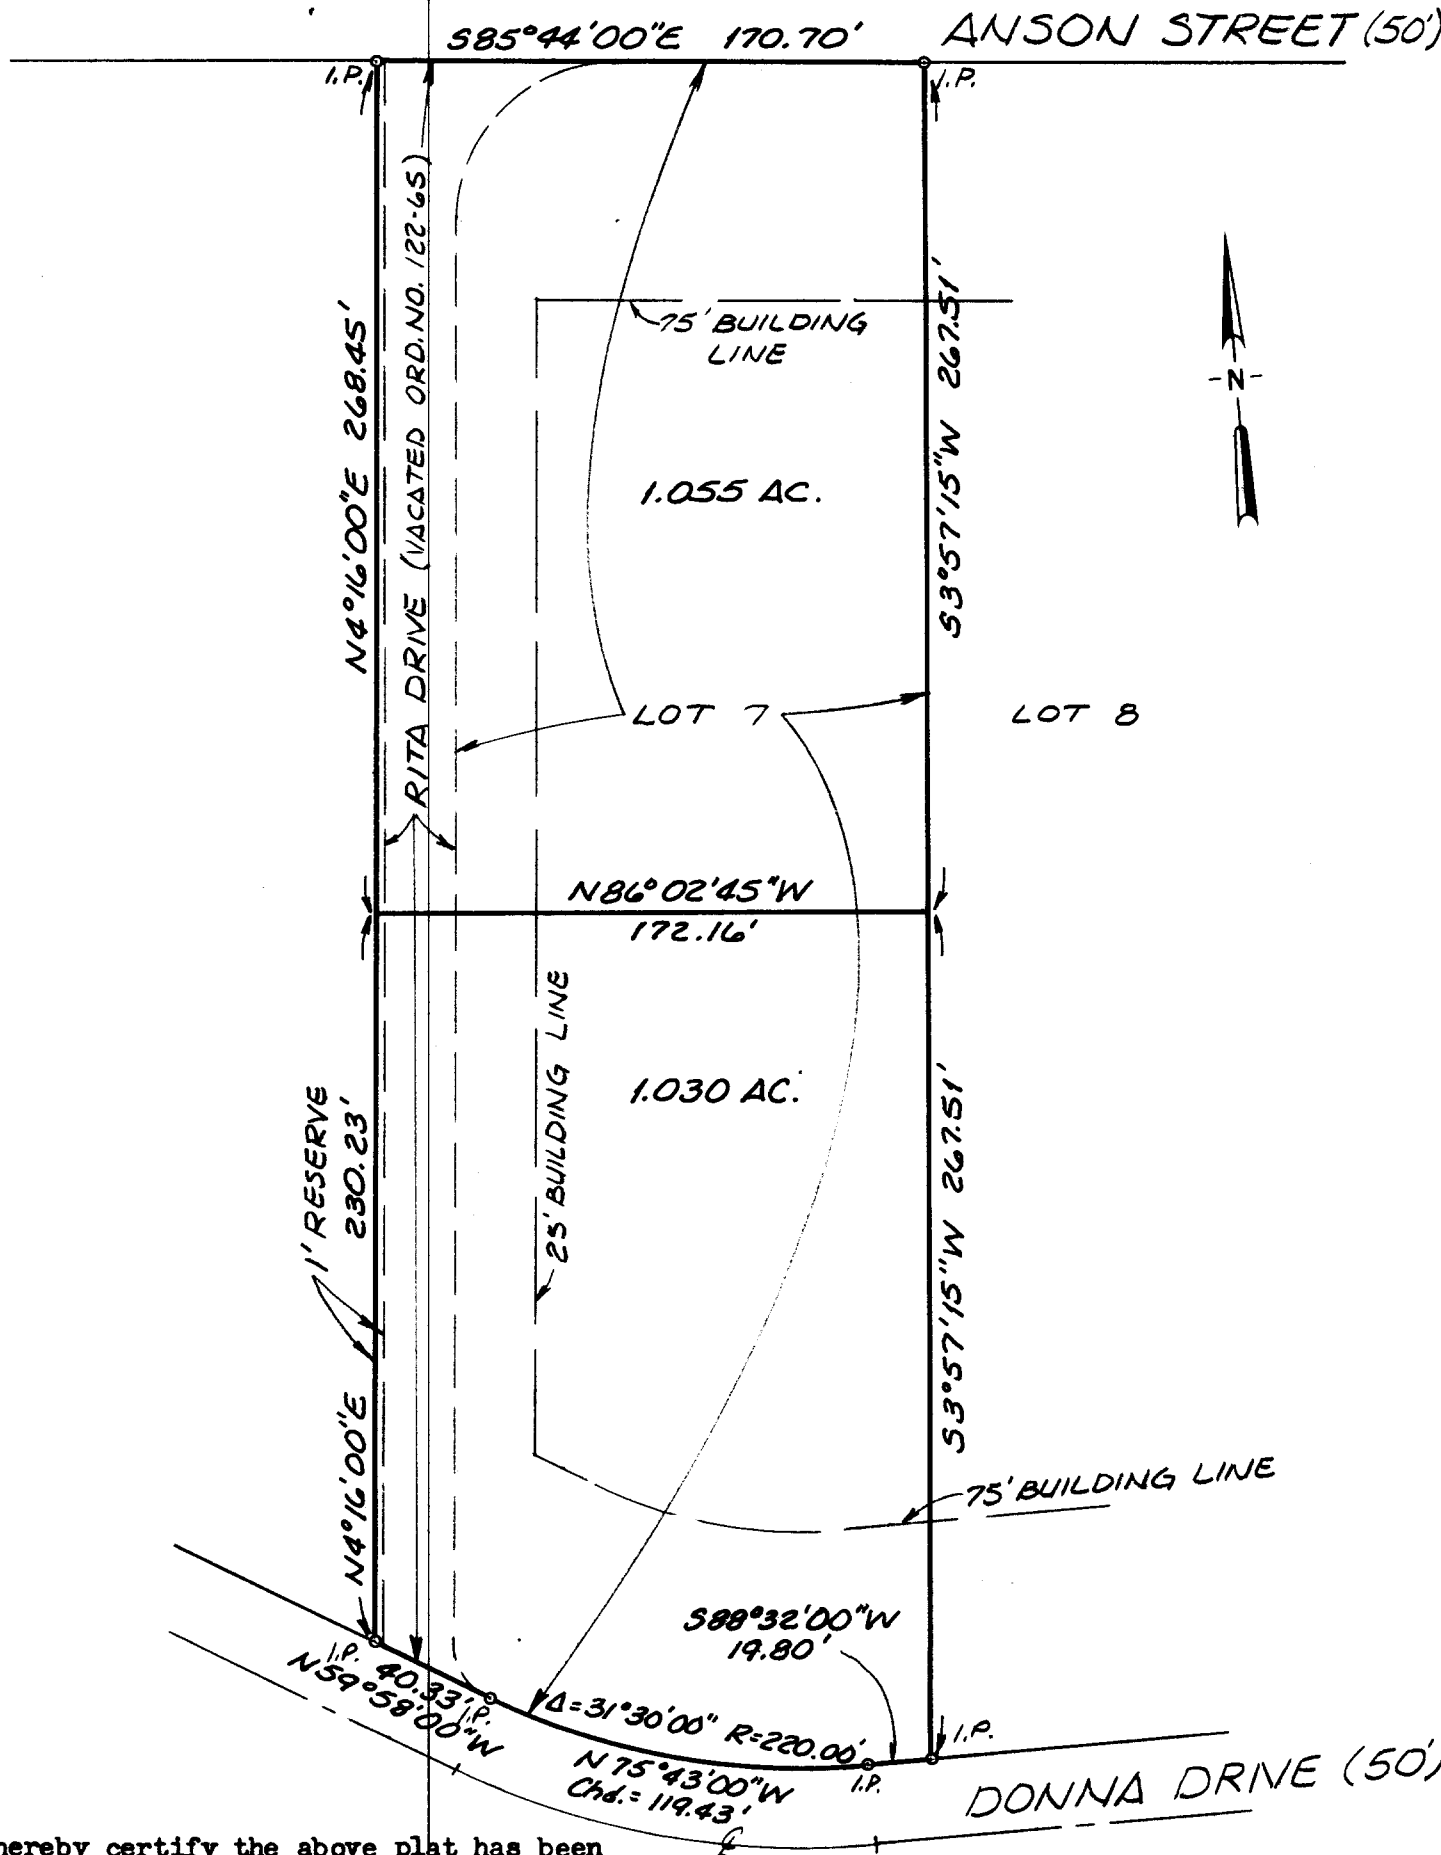

I hereby certify the above plat has been prepared from actual survey of the premises ~~for use in mortgage loan and title purposes only. No side line of principal building is less than dimension shown.~~ Property corners not located unless shown thus -o-

Harry L. Greene
Harry L. Greene, Registered Surveyor, No. 4058