


CHAMBERS ROAD 30'

 

May 19-1969
Scale 1" = 40'

1800 & 1806 NORTH STAR ROAD
City of Columbus, Franklin County, Ohio.
Galbreath Mortgage Company.
Re: Klecker, Dotter & Magleby.
Blue Print Survey
I hereby certify that I have prepared the
above plot from survey and inspection of the
above shown premises and existing conditions
are as shown above.
Being more particularly described per
attached copy.
Harry L. Green