

Harry L. Greene, Surveyor


2160 Tremont Center Columbus, Ohio 43221

For: Freedom Federal Savings & Loan Ass'n.,
Integrity Title Agency.

Re: Craig Root.

See attached legal description.

PB _____ Page _____
 Scale 1" = 40' Date August 25, 1987
 Recorders Office, Franklin County, Ohio.

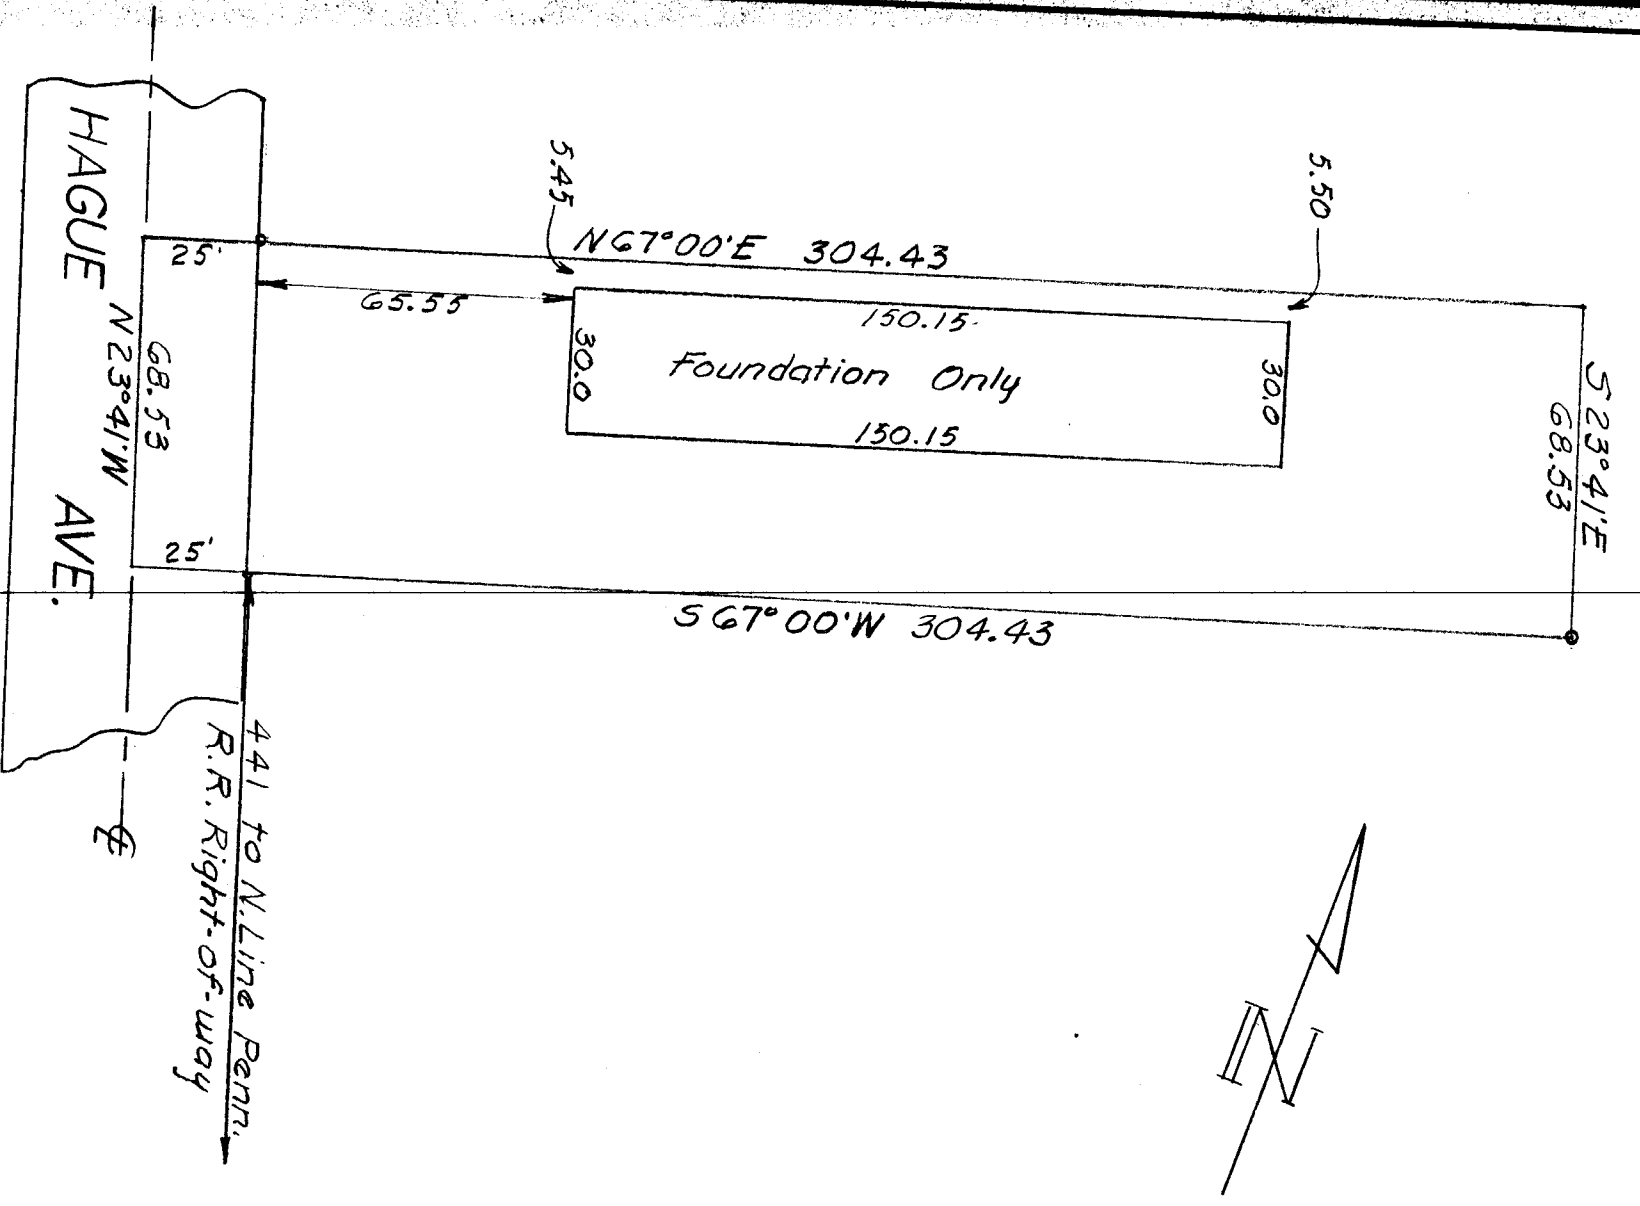

I hereby certify the above plat has been prepared from actual survey of the premises for use in mortgage loan and title purposes only. No sideline of principal building is less than dimension shown. Property corners not located unless shown thus -0-.

Harry L. Greene
 Harry L. Greene, Registered Surveyor, No. 11058