


# Harry L. Greene, Surveyor

2160 Tremont Center, Columbus, Ohio 43221

To: Dollar Savings  
Re: Clayton Ross

Beings Lots Nos. 134 and 135 of Robert Neils Executors, et al, addition to Neilston Park Place Addition, City of Columbus, Ohio. 289, 297 and 303 Cleveland Avenue. 394 and 396 Mt. Vernon Avenue.

PB. 4 Page 438 Recorders Office, Franklin County, Ohio.  
Scale 1" = 40' Date November 10, 1983

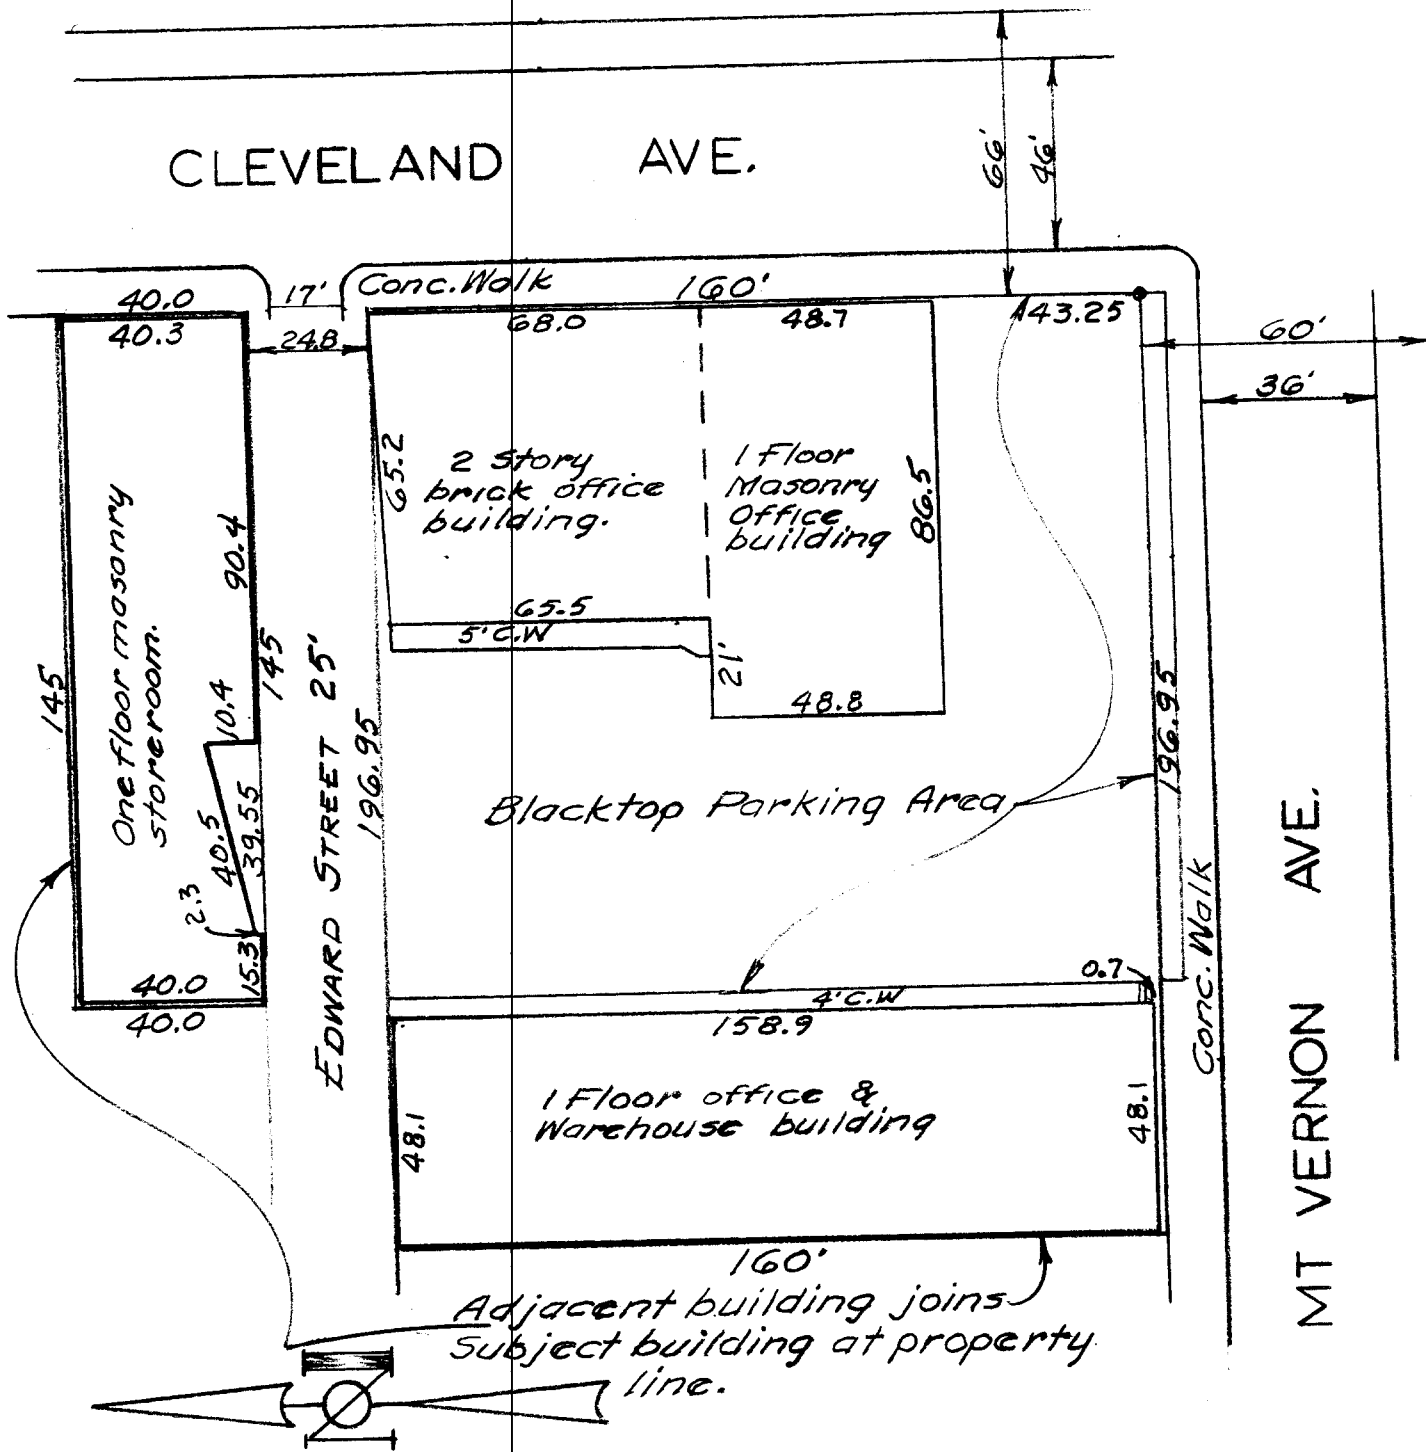

I hereby certify the above plat has been prepared from actual survey of the premises for use in mortgage loan and title purposes only. No sideline of principal building is less than dimension shown. Property corners not located unless shown thus -o-.

*Harry L. Greene*  
Harry L. Greene, Registered Surveyor, No. 405