


Aug. 1962
Scale 1" = 400'
Revised Sept. 1962. *W.D.G.*

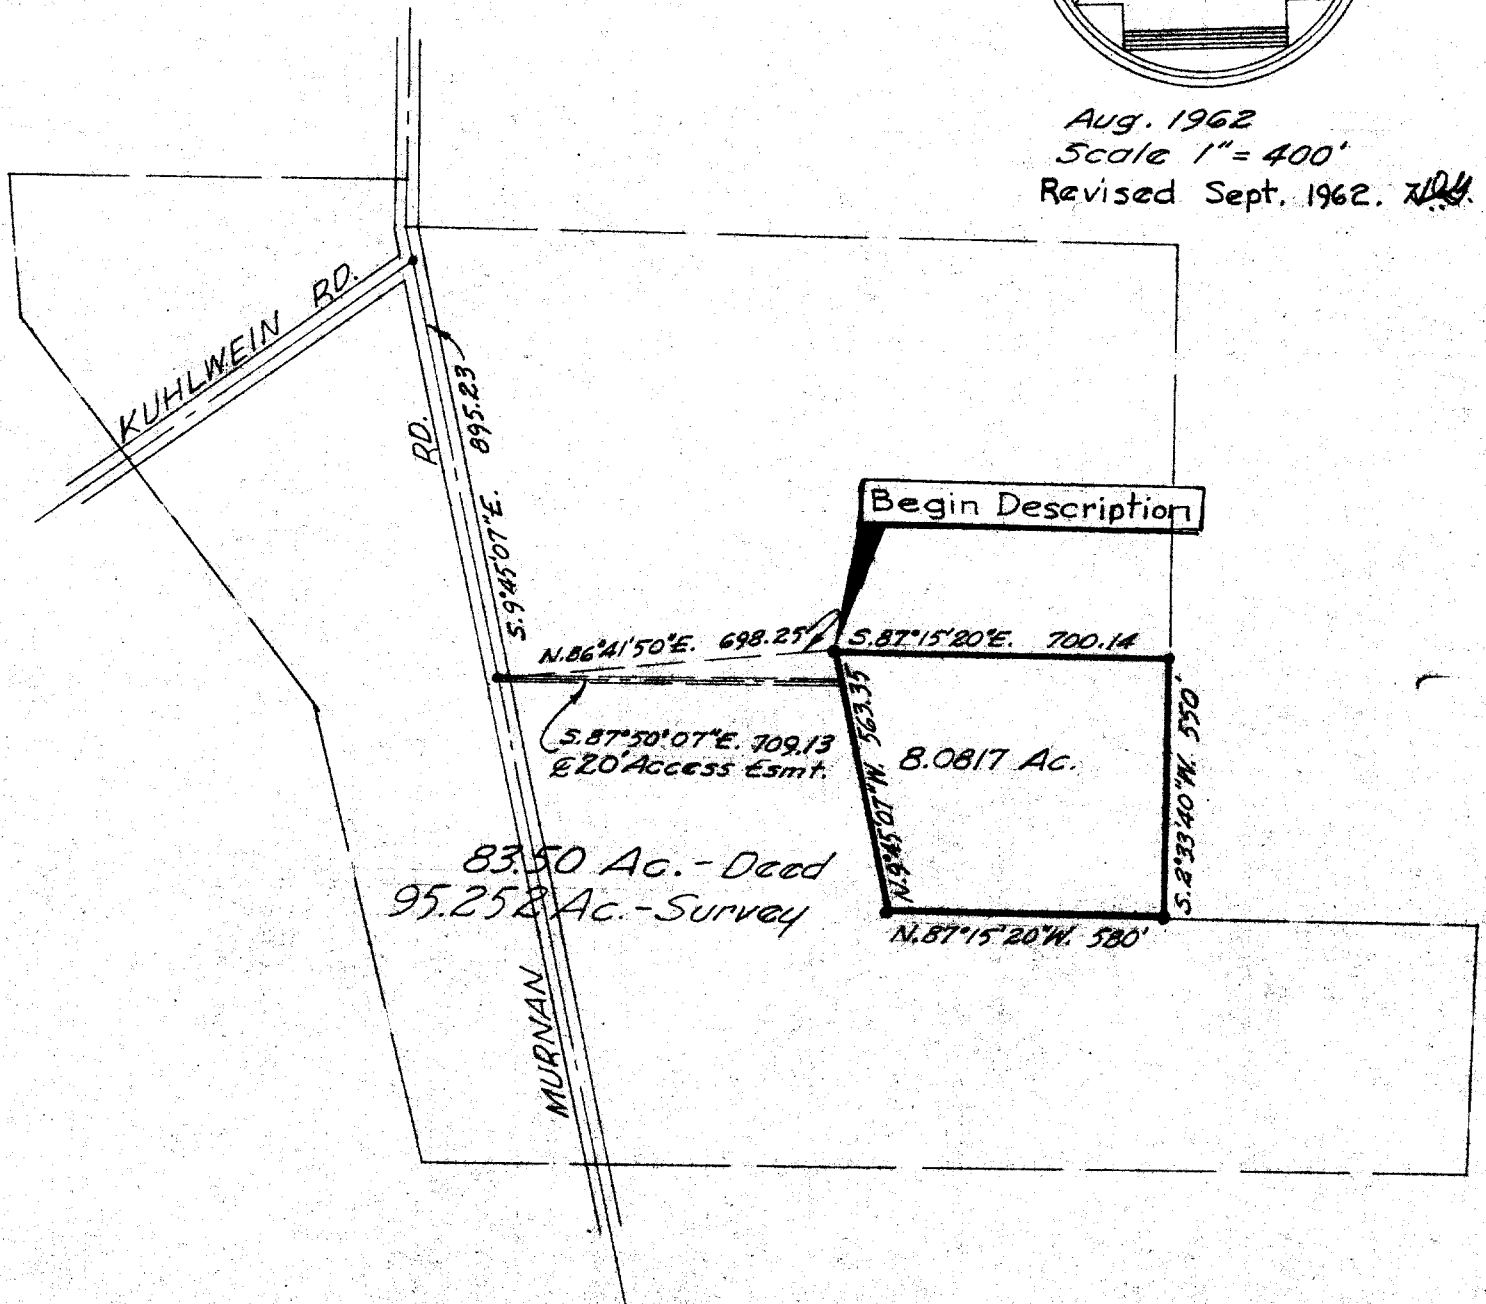

Survey showing an 8.0817 Acre Tract out of an 83.50 Acre Tract, recent survey shows 95.252 Ac., situated in Prairie Township, Franklin County, Ohio.

for
Dick & Sylvia D. Carlson.

Harry L. Greene
Harry L. Greene, Reg. Surveyor - No. 4058.