
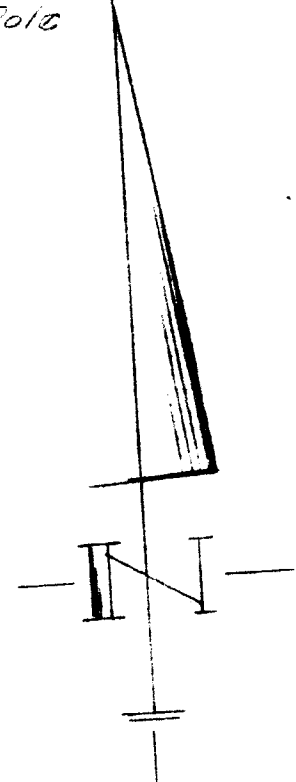


KARL

RD. 30'

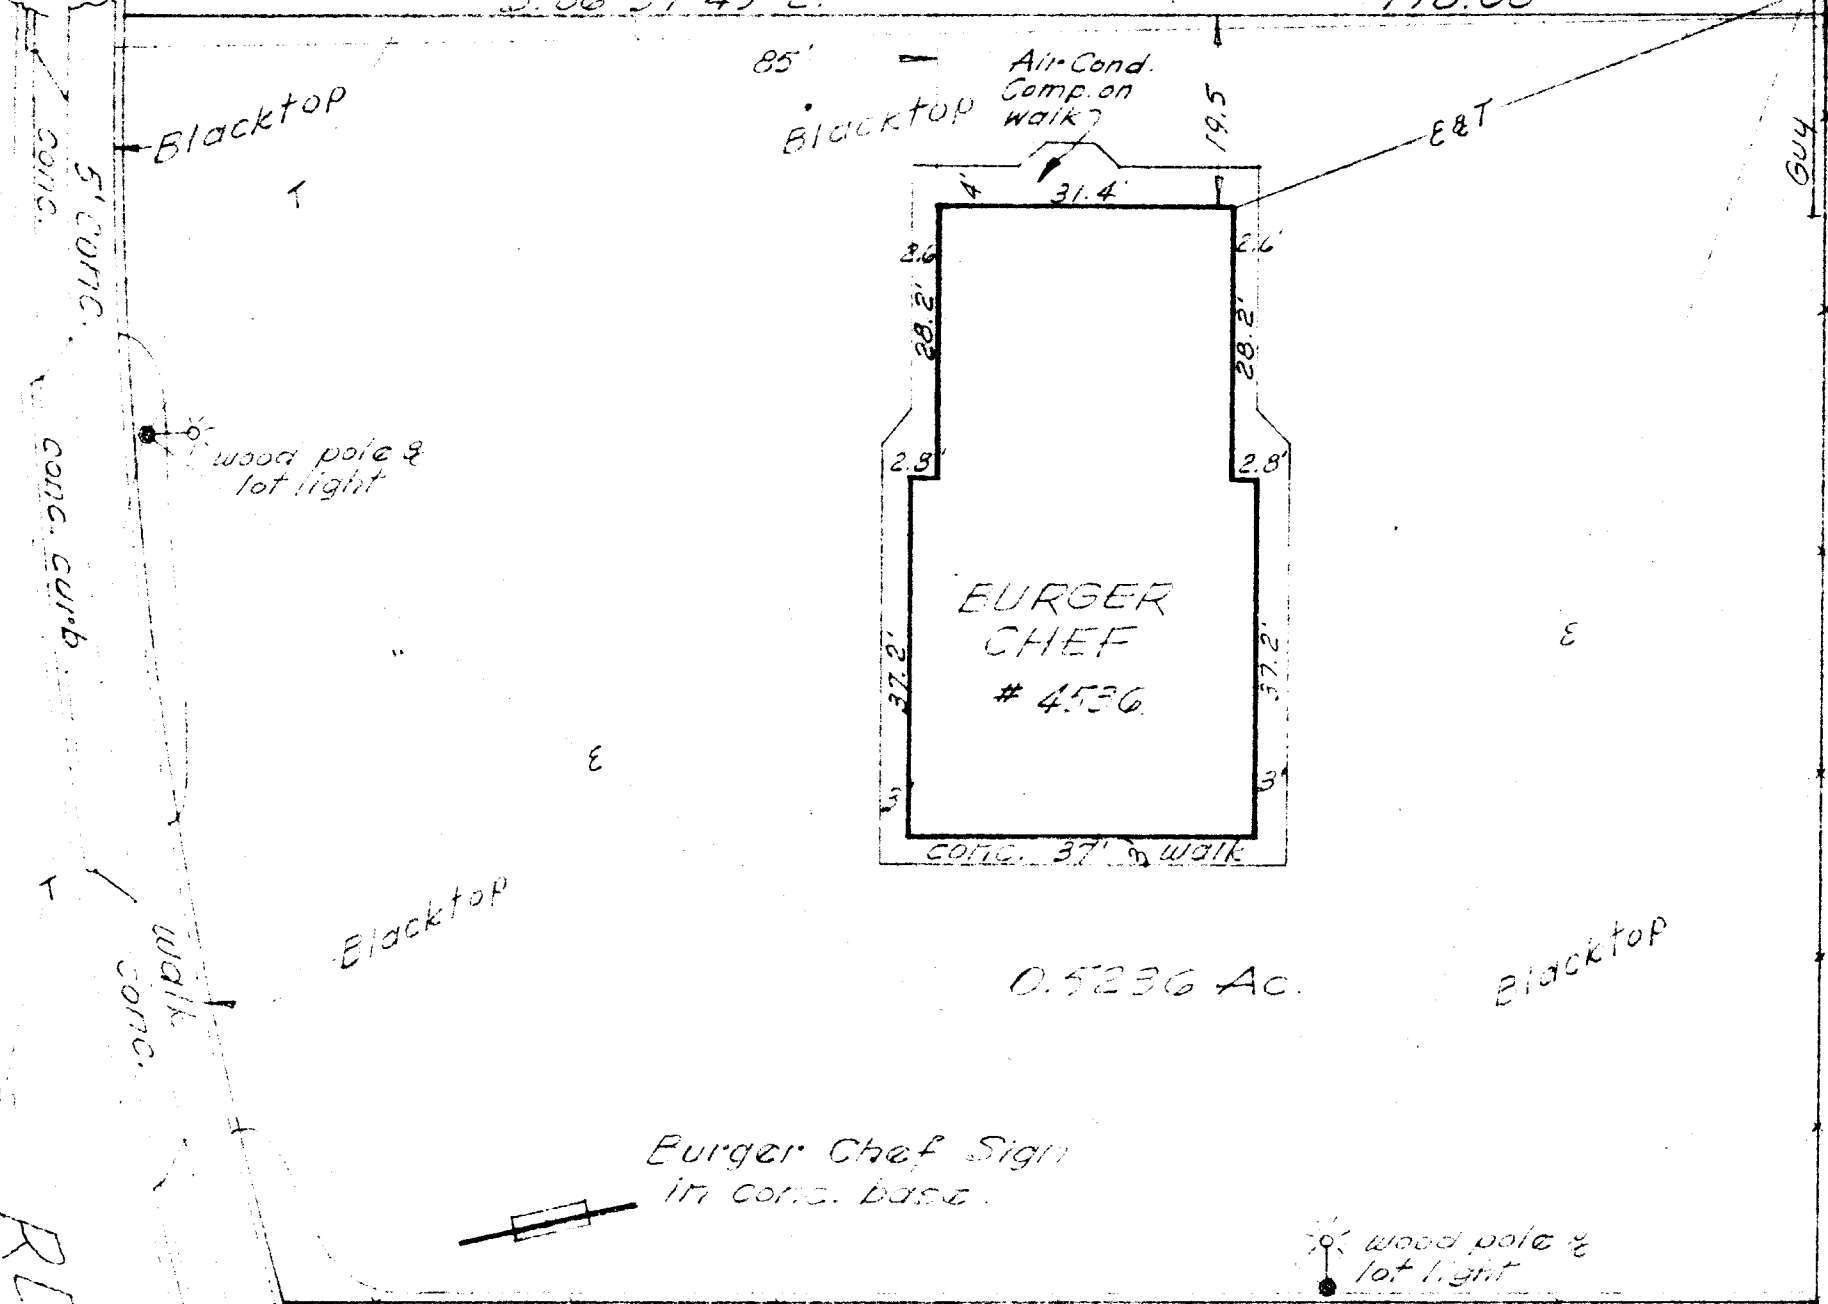

May 20, 1976
Scale 1" = 20'

Burger Chef Sign
in conc. base.

Plot showing property of Fred L. Hirsch,
4536 KARL ROAD, City of Columbus, Franklin
County, Ohio.

Harry L. Greene
Harry L. Greene, Reg. Surveyor - 4058.