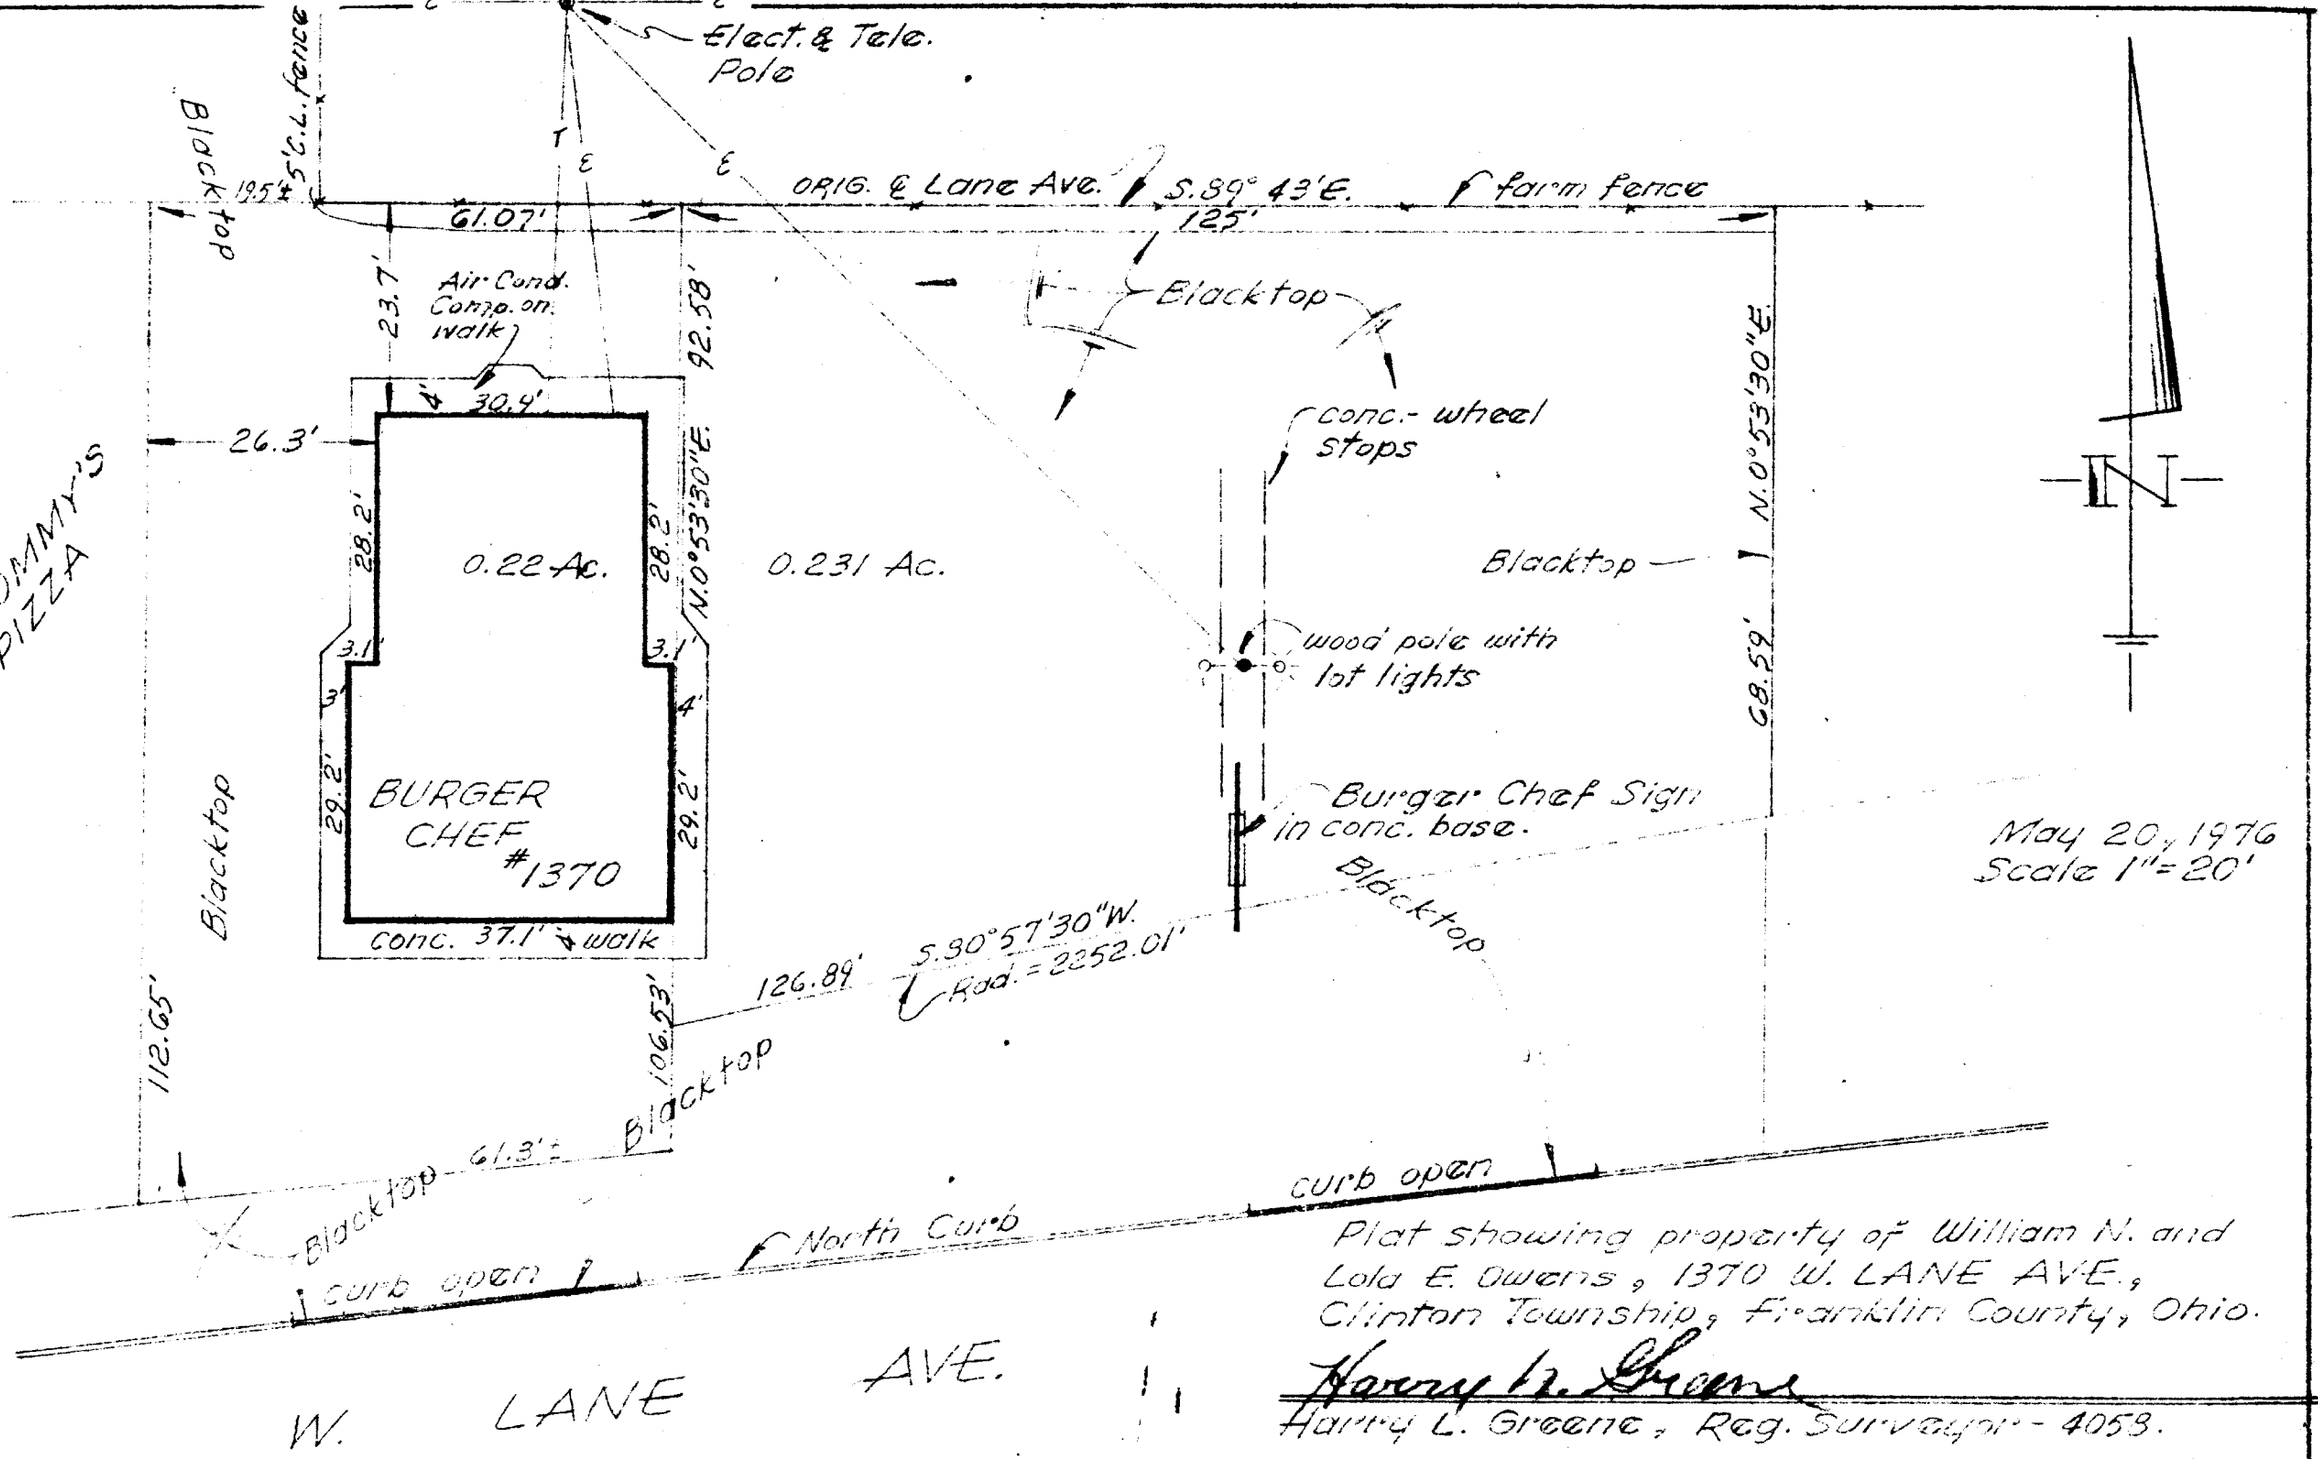

Plat showing property of William N. and Lola E. Owens, 1370 W. LANE AVE., Clinton Township, Franklin County, Ohio.

Harry L. Greene

Harry L. Greene, Reg. Surveyor - 4053.