

Harry L. Greene, Surveyor

2160 Tremont Center, Columbus, Ohio 43221

For: ARTA
and/or
Diamond Savings & Loan
Re: Wayne L. Schlegel & Beverly A. Schlegel

See legal description attached hereto and hereby made a part of this survey.

PB. _____ Page _____ Records Office, Franklin County, Ohio.



Scale 1" = 200' Date May 13, 1986

N.W. Cor. Sect. 19

58°50'57"E
200.16
N89°31'30"E
164.69

Blackstones Hilltop
Subdivision No. 2.
Vol. 8, Page 63.

58°31'48"E
373.66

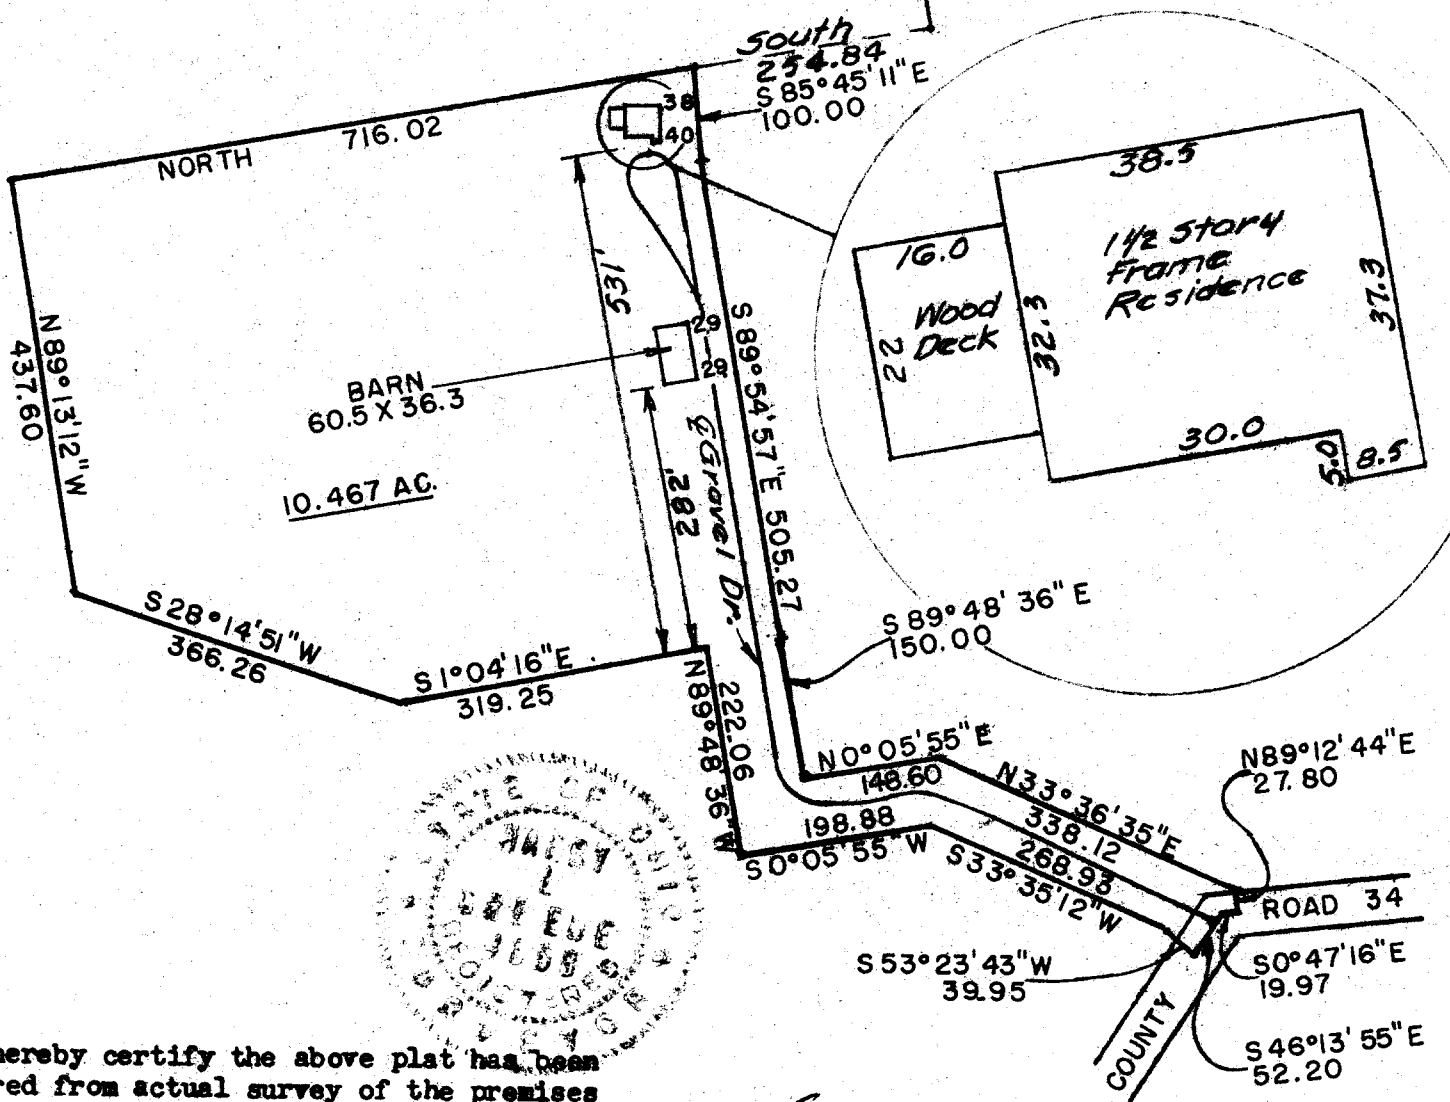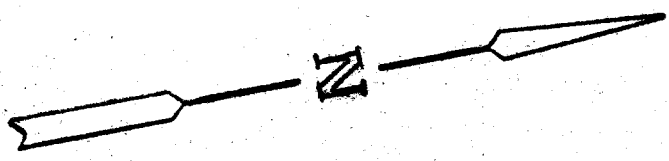

I hereby certify the above plat has been prepared from actual survey of the premises for use in mortgage loan and title purposes only. No sideline of principal building is less than dimension shown. Property corners not located unless shown thus -o-.

Harry L. Greene
 Harry L. Greene, Registered Surveyor, No. 4058