Harry L. Greene, Surveyor

2160 Tremont Center, Columbus, Ohio 43221

PLAT SHOWING SURVEY OF 0.1941 ACRES AND 0.2088 ACRES, IN THE CITY OF UPPER ARLINGTON, FRANKLIN COUNTY, OHIO, BEING PART OF LOT NO.9 OF JAMES T. MILLER"S AMRBLE CLIFF FARM SUBDIVISION, AS SHOWN OF RECORD IN PLAT BOOK 5, PAGE 34, RECORDER'S OFFICE, FRANKLIN COUNTY, OHIO.

For Mr. George S. Frost.

P.B. 5 Page 34 Recorders Office, Franklin County, Ohio.
Scale 1" = 100' Date January 27, 1988.

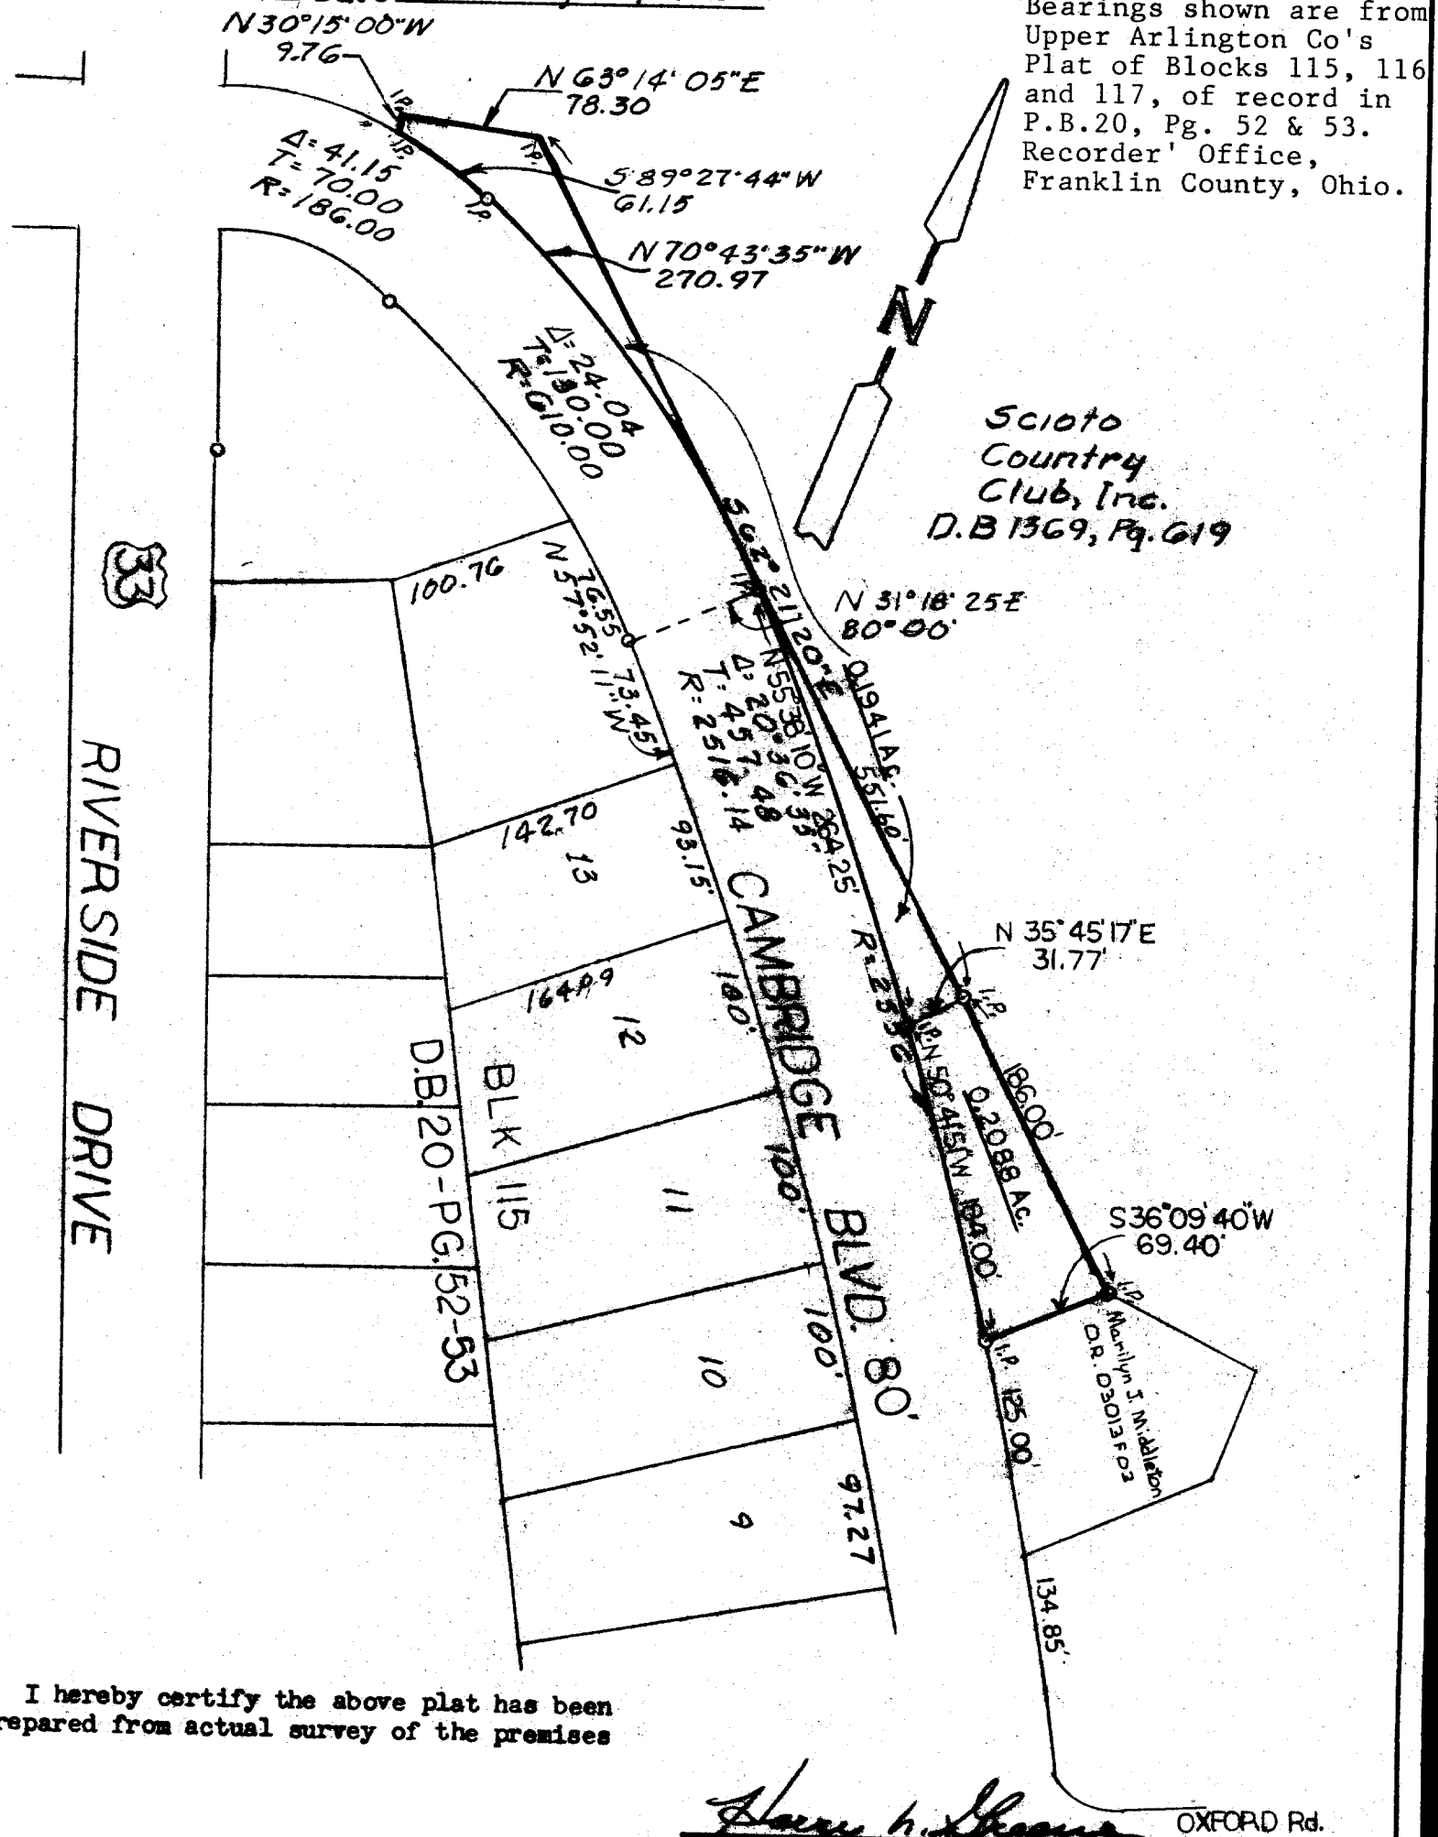

I hereby certify the above plat has been prepared from actual survey of the premises

Harry L. Greene

Harry L. Greene, Registered Surveyor, No. 4058