


F. W. Legg

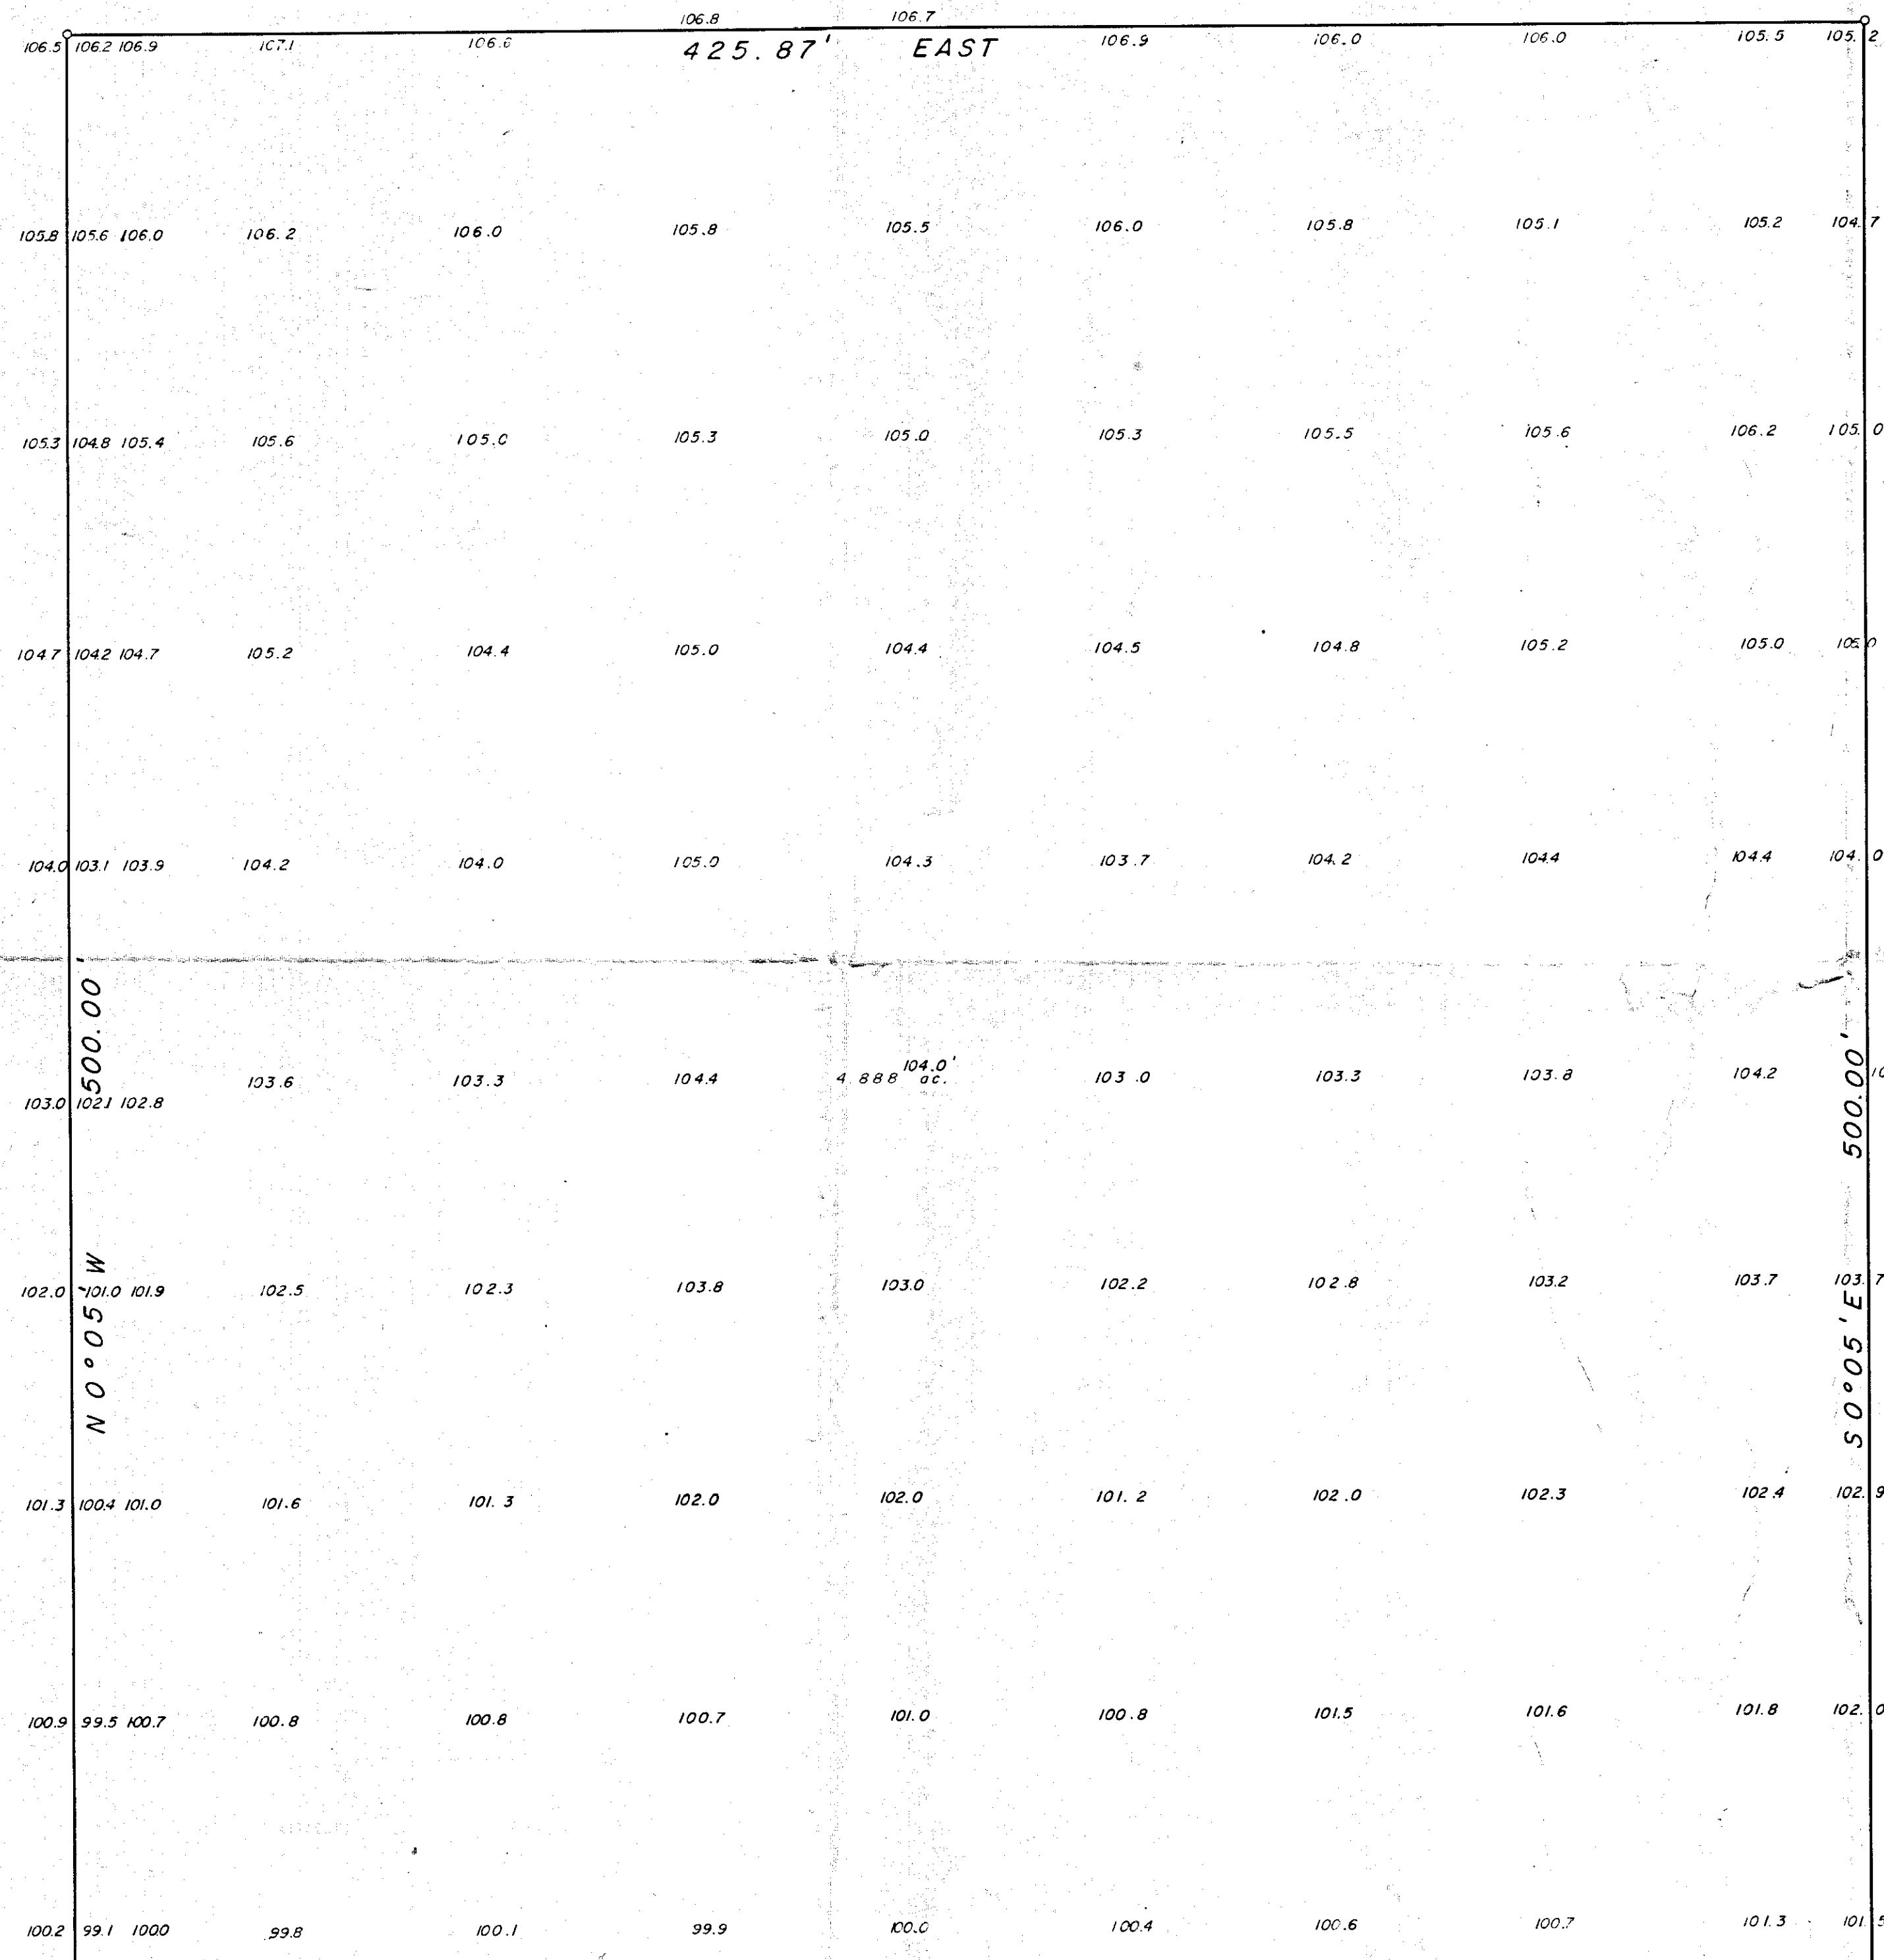

BOUNDARY SURVEY OF PART OF FARM LOT 51 (CHANCERY RECORD 4, P. 285 FRANKLIN COUNTY, OHIO COURT HOUSE), SECTION 2, TOWNSHIP 2, RANGE 18, UNITED STATES MILITARY LANDS, SHARON TOWNSHIP, FRANKLIN COUNTY, OHIO.

SHARON TOWNSHIP BOARD OF TRUSTEES  
FLINT CEMETERY


Scale 1" = 30'

14 November, 1960

Rev. 10 Oct., 1961 for additional acreage in Farm Lot 52.  
Rev. 10 NOV., 1961 for topographic survey.

F. W. Legg  
D. B. 2278, P. 412

*D. W. Smith*  
F. W. Smith, registered surveyor  
MYERS SURVEYING CO.  
Civil Engineers & Surveyors  
Bexley, Ohio

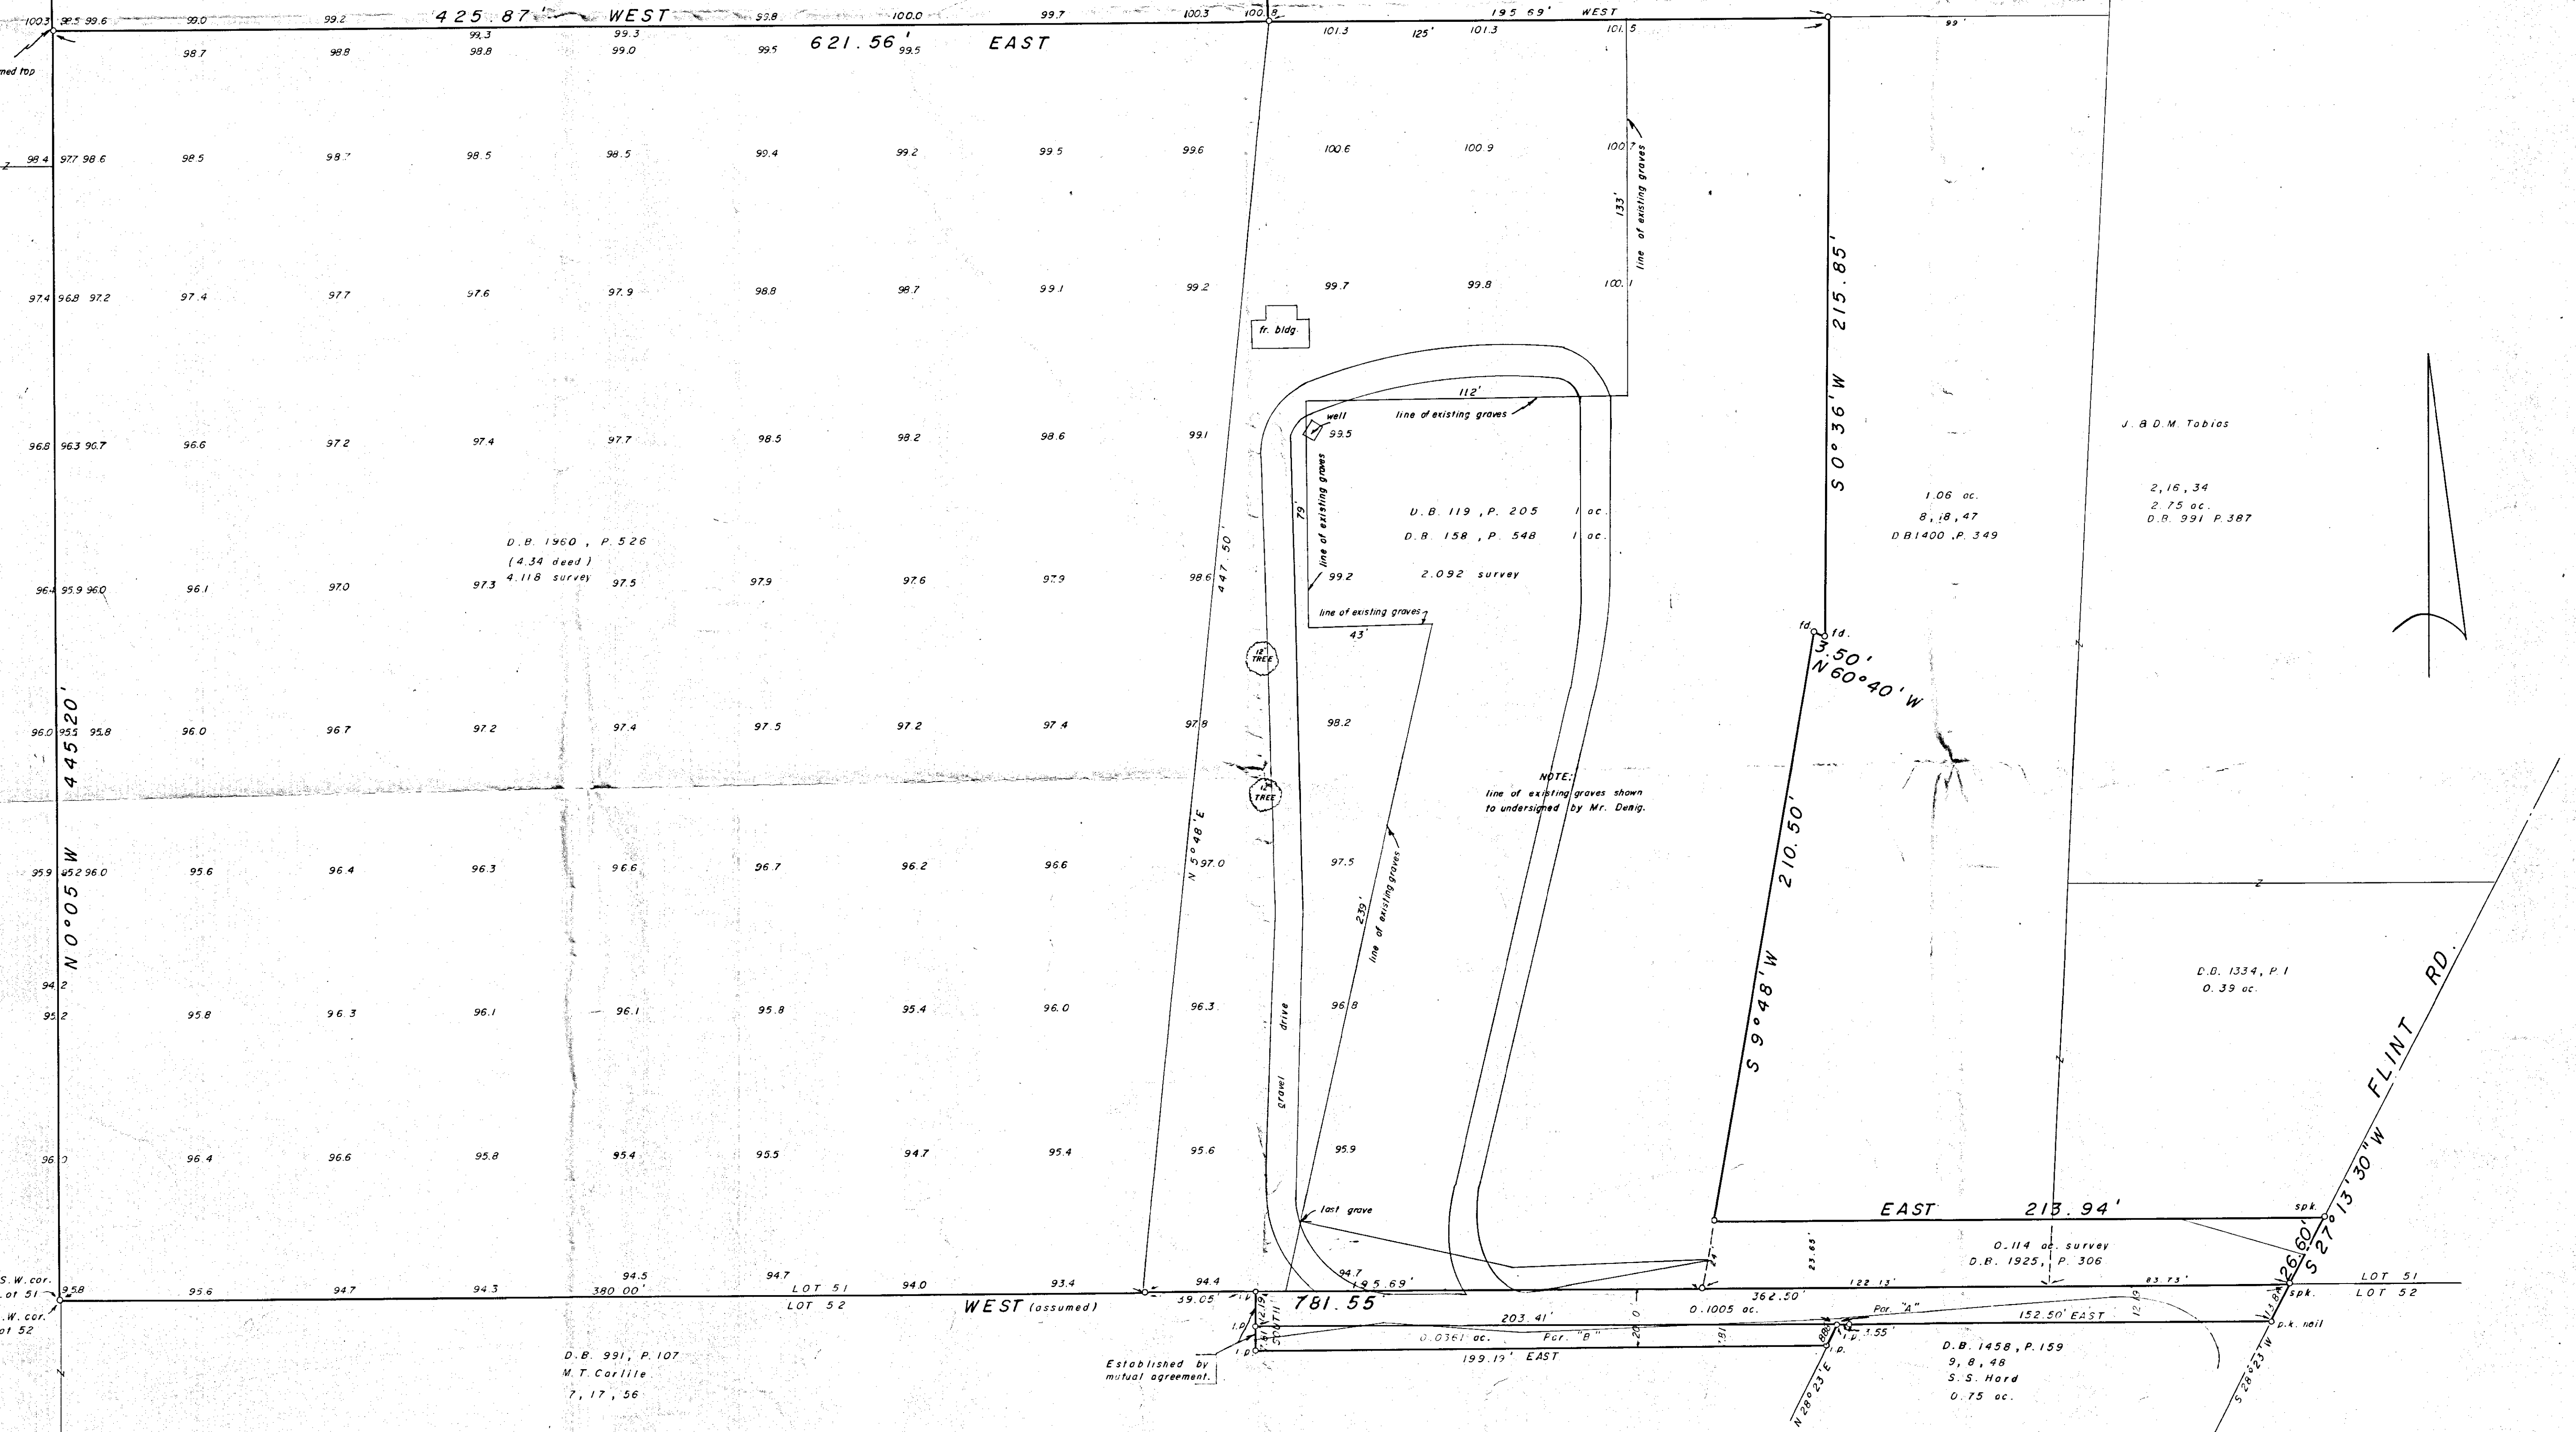

Established by mutual agreement.

D. B. 991, P. 107  
M. T. Corliss  
7, 17, '56

D. B. 1458, P. 159  
S. S. Hard  
0, 75 ac.

D. B. 1334, P. 1  
0, 39 ac.

J. B. O. M. Tobias  
2, 16, 34  
2, 75 ac.  
D. B. 991, P. 387

U. B. 119, P. 205 1 ac.  
D. B. 158, P. 548 1 ac.  
2, 092 survey

NOTE:  
line of existing graves shown to undersigned by Mr. Denig.