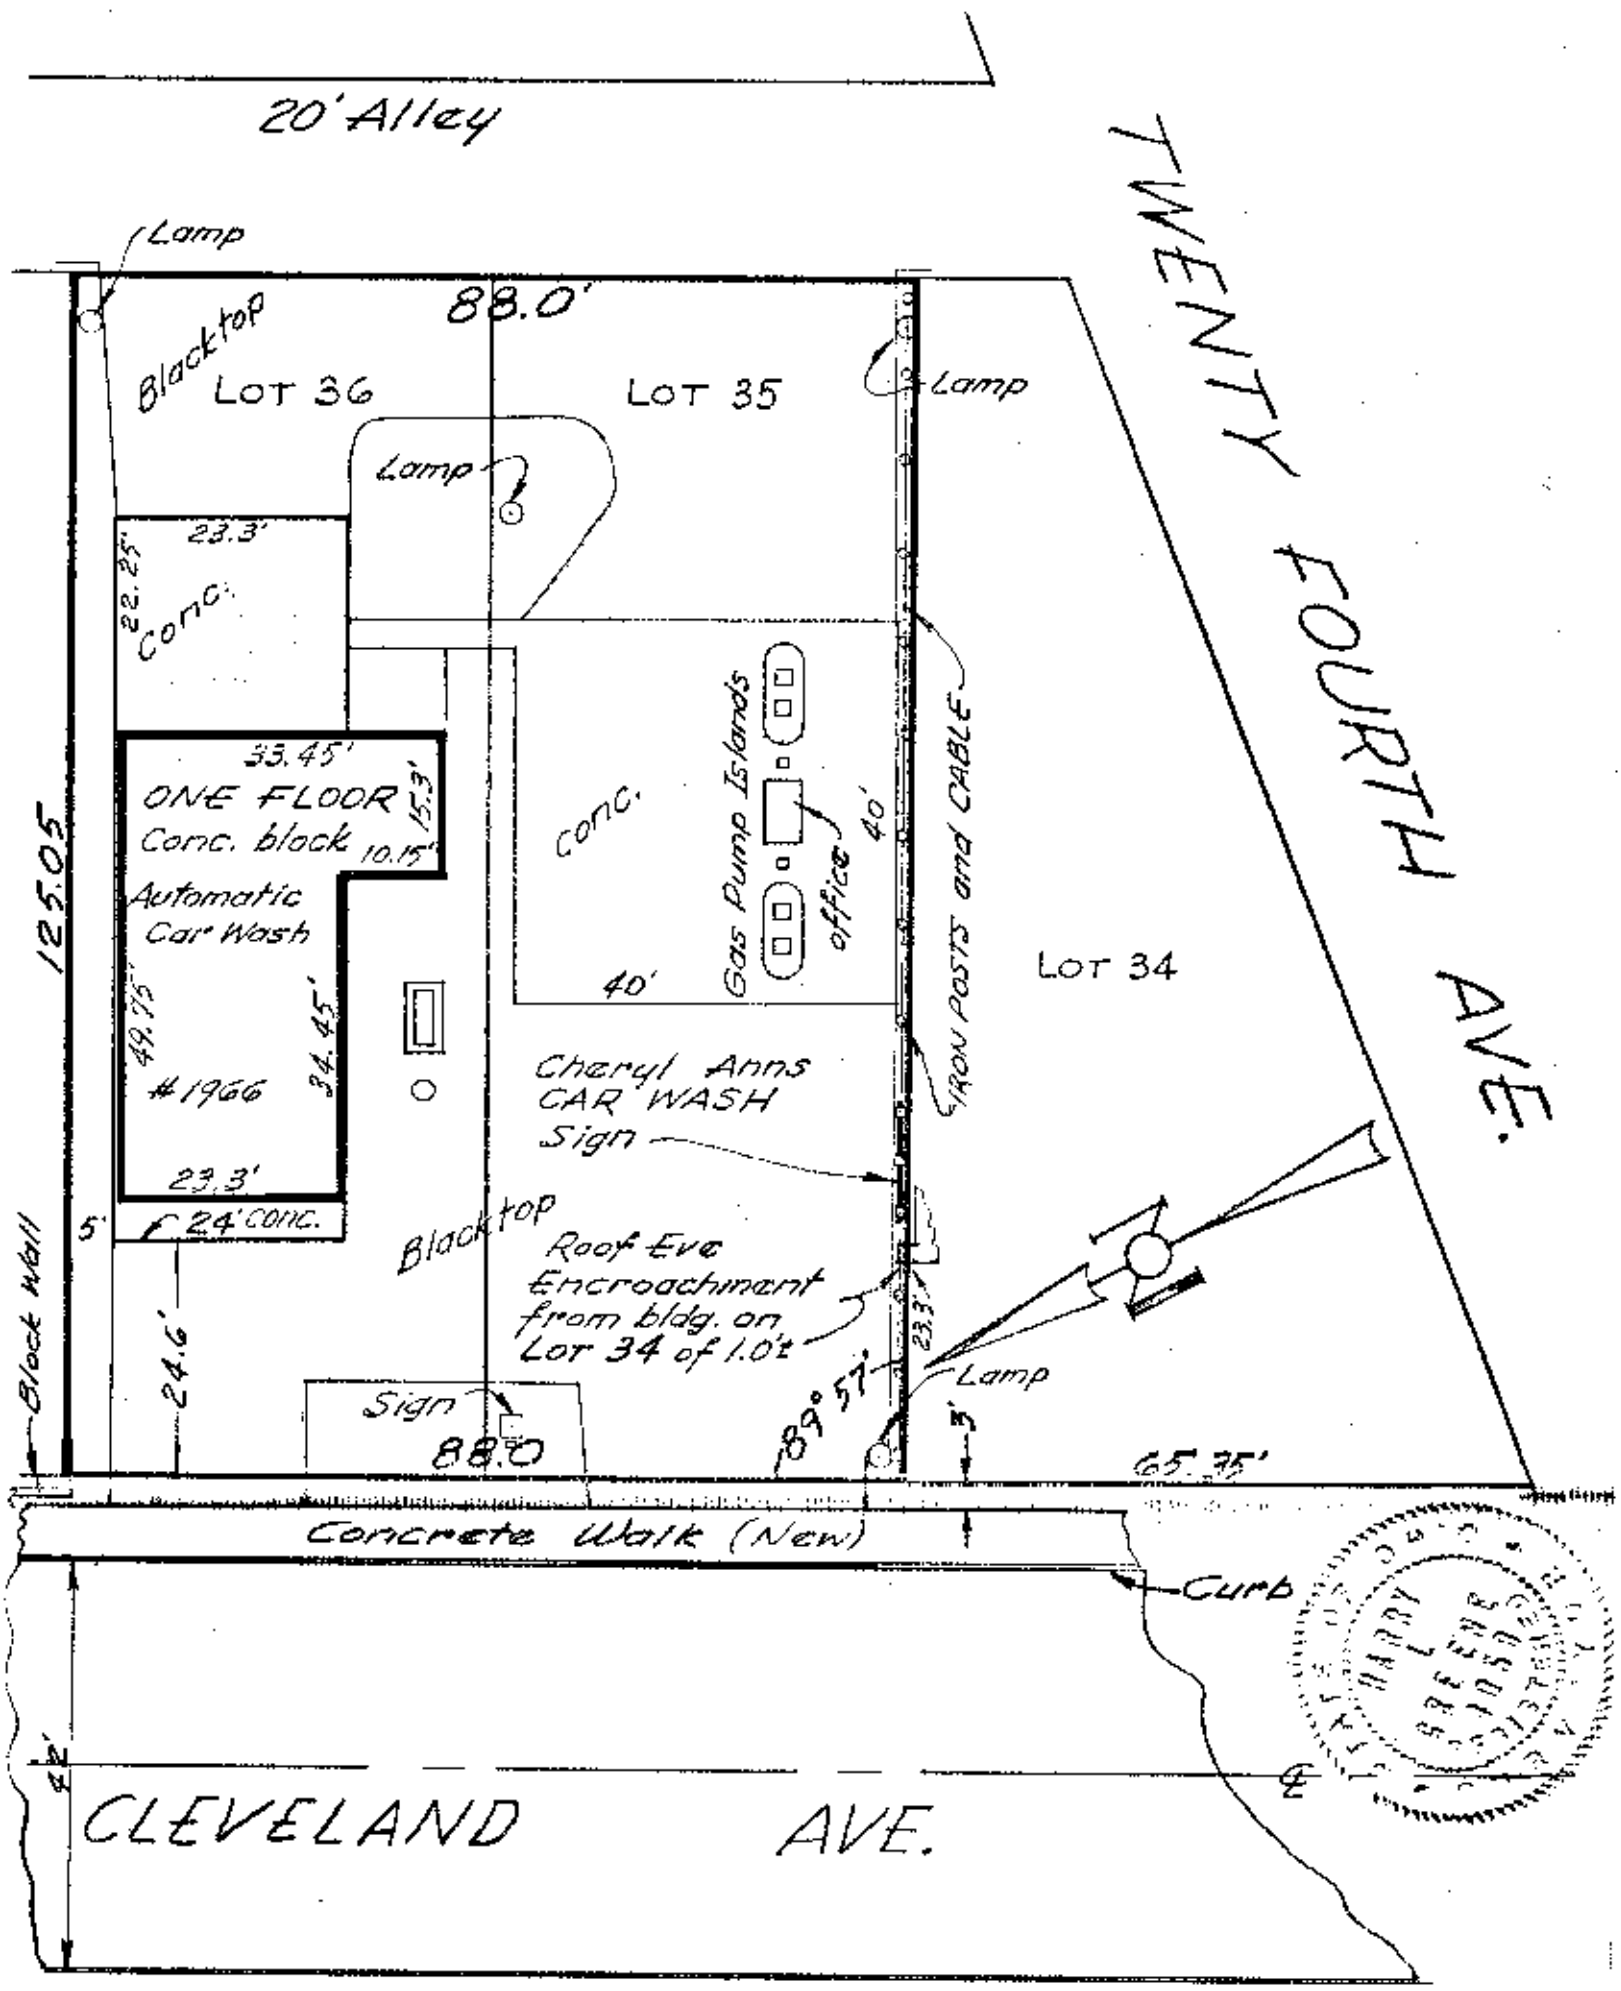

1966 CLEVELAND AVENUE
City of Columbus, Franklin County, Ohio.
"To New York Life Insurance Company,
The Galbreath Company.
I hereby certify that I personally made an actual survey of the premises shown on this plot plan on the 18th day of November, 1971; that this plot is a correct representation of the premises as determined by said survey. I further certify that there are no encroachments either way across any boundary line of the premises or across any easements except as shown hereon.
Being Lots 35 and 36 of WALDEMERE, Plat Book 10, Pages 86 and 87, Recorder's Office, Franklin County, Ohio.
Signed at Columbus, Ohio, this 24th day of November, 1971.

Harry L. Greene

Harry L. Greene, Reg. Surveyor - No. 4058.